

OREGON CORNER RESTORATION FORM

COUNTY: Umatilla. DATE: 04/06/23.

CORNER DESIGNATION: N-5, the Southeast corner of Section 18, Township 3 North, Range 28 East, W.M.

PREVIOUS RENEWALS/SURVEYS ETC: Corner N-5, the Southeast corner of Section 18, was originally established by N.H. Gates under Contract No. 84, dated July 22, 1859. Gates set a post in earth mound. Survey No. Q-506-A, by Newbill in 1954, reestablished the corner position with reference to other monuments found on his retracement of the East line of Section 18. Newbill did not set a corner monument. In Survey No. 00-33-B retraced Survey No. Q-506-A and monumented the Northeast and East Quarter corner of Section 18 and computed a position for the Southeast corner of Section 18, but did not remonument it as it fell in a plowed field.

MONUMENT AND ACCESSORIES FOUND: I computed the corner position per Survey No. Q-504-A and 00-33-B. The corner point falls in an irrigation circle. A monument was not set at the request of the landowner. Dave Haddock, in his Survey No. 00-33-B, notes the corner point is "impractical to set".

CORNER DESIGNATION:

T3N R28E
S18 | S17

S19 | S20

I reference the corner position as follows:

New Accessories to corner position in irrigation circle:

A 5/8"X24" rebar with blue plastic cap marked "Wells Surveying 54657PLS bears S 58°17'13" W, 166.27', set near the NE 4" bollard protecting a monitoring well. Wired witness post sign and bearing object sign to the bollard..

A 5/8"X24" rebar with blue plastic cap marked "Wells Surveying 54657PLS bears S 01°41'32" E, 114.85'. The cap is 2" below ground line in straw bale laydown area.

A 5/8"X24" rebar with blue plastic cap marked "Wells Surveying 54657PLS bears S 61°15'43" E, 298.94'. The cap is 2" below ground line in straw bale laydown area..

A 5/8"X24" rebar with blue plastic cap marked "Wells Surveying 54657PLS bears S 69°46'58" E, 448.71'. Set steel fence post, set in unfarmed area East of straw bale laydown area, with witness sign, 1' West of rebar. Wired bearing object sign to rebar.

Courses to corner accessories are Oregon State Plane Grid bearings and distances.

LOCATION AND COMMENTS: The corner falls in an irrigation circle.

OREGON STATE PLANE COORDINATE, North Zone NAD 83(91), International Feet Units:


N: 755652.25

E: 8495211.95

FIRM: Wells Surveying
P.O. Box 1696
Pendleton, OR 97801

Surveyor's Seal

\3N28N-5

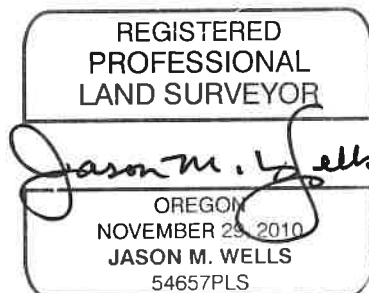

RENEWS: 6.30.24

24-004-C