

OREGON CORNER IDENTIFICATION FORM

Section 3, 34
County Umatilla

Township 3N
Date: 12/31/08

Range 29E

Corner Designation: 3N29A15

1/4 corner common to sections 34, T4NR29E, 3, T3NR29E.

- Condition Report Only
- Not Found
- Remonumented
- Unrecorded
- Surveyed In
- Referenced Out


Previous Renewals / Surveys, etc.

Originally Surveyed by Gates in 1859. He set a post in a mound of earth.
In 1998 Edwards set a 1"x30" Iron pipe with a 2 3/8" B.C. by single proportion.
In 2001 Primm found a 2 3/8" B.C.
In 2002 Haddock found a 2 1/2" B.C.


Monuments and Accessories Found: (Condition and Source)

A 2 3/8" B.C.
An aluminum tag #951 and nail on a power pole lies N 61°00' W, 58.40'
An aluminum tag #951 and nail on a power pole lies N 08°45' E, 108.50'.
An aluminum tag #951 and nail on a power pole lies N 64°30' E, 83.58'.
An aluminum tag #951 and nail on a railroad tie fence post lies S 13°00' E, 14.37'.

Diagram

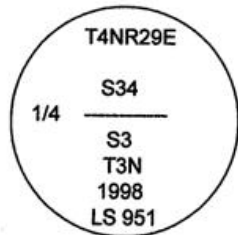

Sketch

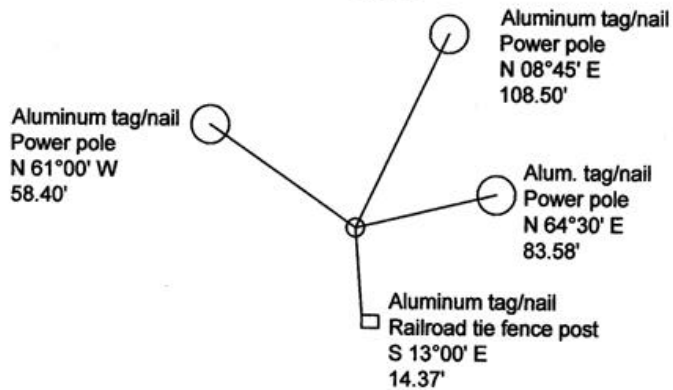

NAD 83/91
OREGON STATE PLANE NORTH
INTERNATIONAL FEET

N 772235.394
E 8540393.774

LAT - 45° 46' 37.91581" N LON - 119° 10' 26.68332" W

Monument (s) Set (Procedures and Description)

None.

References Set:

Location and Comments

The corner is in the intersection of Old Stage Gulch Rd. and Cooper Rd.

Compass Declination
17° E

Surveyors Seal

REGISTERED
PROFESSIONAL
LAND SURVEYOR

Robert D. English
OREGON
JANUARY 11, 2005
ROBERT DOUGLAS ENGLISH
43406LS

RENEWAL DATE: 12/31/09

RECEIVED BY:

Date: 1-09
Rec'd By: KK
No. 09-17-R

Firm / Agency

Survey One, LLC.
P.O. Box 382
Pendleton, OR 97801
(541) 276-2055