

OREGON CORNER RESTORATION FORM

Section 3, 34

Township 3N

Range 29E

County Umatilla

Date: 12/31/08

Corner Designation: 3N29A15

1/4 corner common to sections 34, T4NR29E, 3, T3NR29E.

- Condition Report Only
- Not Found
- Remonumented
- Unrecorded
- Surveyed In
- Referenced Out


Previous Renewals / Surveys, etc.

Originally Surveyed by Gates in 1859. He set a post in a mound of earth.
 In 1998 Edwards set a 1"x30" Iron pipe with a 2 3/8" B.C. by single proportion.
 In 2001 Primm found a 2 3/8" B.C.
 In 2002 Haddock found a 2 1/2" B.C.


Monuments and Accessories Found: (Condition and Source)

A 2 3/8" B.C.
 An aluminum tag #951 and nail on a power pole lies N 61°00' W, 58.40'
 An aluminum tag #951 and nail on a power pole lies N 08°45' E, 108.50'.
 An aluminum tag #951 and nail on a power pole lies N 64°30' E, 83.58'.
 An aluminum tag #951 and nail on a railroa tie fence post lies S 13°00' E, 14.37'.

Diagram

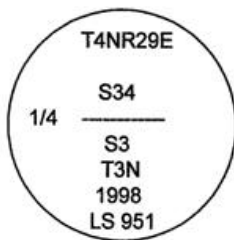

Sketch

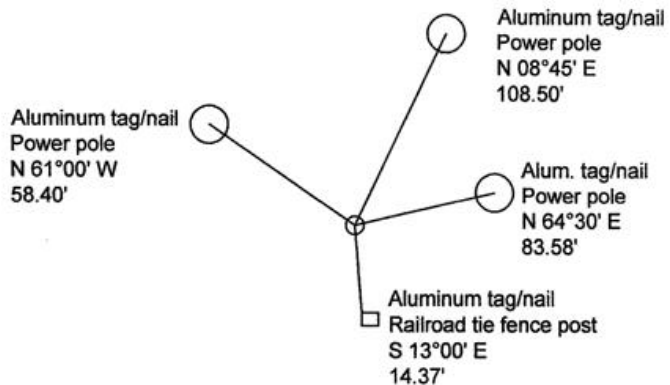

NAD 83/91
 OREGON STATE PLANE NORTH
 INTERNATIONAL FEET

N772230.55
 E8540399.09

LAT - 45° 46' 37.86718" N LON - 119° 10' 26.60939" W

Monument (s) Set (Procedures and Description)

None.

References Set:

Location and Comments

The corner is in the intersection
 of Old Stage Gulch Rd. and
 Cooper Rd.

Compass Declination

17° E

Surveyors Seal

REGISTERED
 PROFESSIONAL
 LAND SURVEYOR

Robert D. English
 OREGON
 JANUARY 11, 2005
 ROBERT DOUGLAS ENGLISH
 43406LS

RENEWAL DATE: 12/31/09

RECEIVED BY:

Date: 1-11
 Rec'd By: KK
 No. 11-008-R

Firm / Agency

Survey One, LLC.
 P.O. Box 382
 Pendleton, OR 97801
 (541) 276-2055