

**OREGON CORNER RESTORATION FORM**

Section 2,3 Township 3N  
County Umatilla Date: 08/12/10

Range 29E

Corner Designation: 3N29C17

Corner common to sections 2,3 T3NR29E.

_____	Condition Report Only
<u>  X  </u>	Not Found
_____	Remonumented
<u>  X  </u>	Unrecorded
<u>  X  </u>	Surveyed In
<u>  X  </u>	Referenced Out



**Previous Renewals / Surveys, etc.**

Originally Surveyed by Gates. He set a post in a mound of earth in 1859.

**Monuments and Accessories Found: (Condition and Source)**

None.

**Diagram**

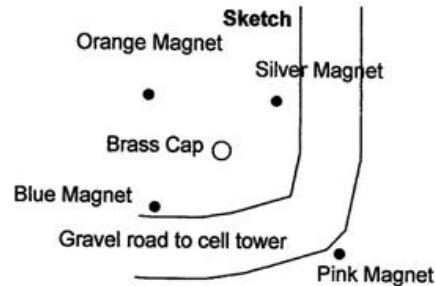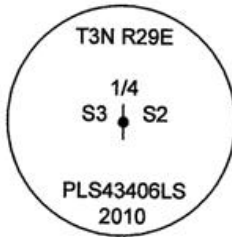

NAD 83/91  
OREGON STATE PLANE NORTH  
INTERNATIONAL FEET

N769603.49  
E8543138.65

LAT - 45° 46' 11.48847" N  
LON - 119° 09' 48.57455" W

**Monument (s) Set (Procedures and Description)**

A 1 1/4" x 30" galvanized iron pipe with a 2 1/2" brass cap, 18" below the surface, stamped as shown above.

**References Set:** "Deep One" magnets by Berntsen.

- An Orange magnet 23" deep lies N 38°40' W, 14.40'.
- A Silver magnet 22" deep lies N 42° E, 14.15'.
- A Pink magnet 22" deep lies S 25°30' E, 29.70'.
- A Blue magnet 22" deep lies S 48° W, 14.14'.

**Location and Comments**

**Compass Declination**  
17° E

**Surveyors Seal**

REGISTERED  
PROFESSIONAL  
LAND SURVEYOR

*Robert D. English*  
OREGON  
JANUARY 11, 2005  
ROBERT DOUGLAS ENGLISH  
43406LS

**RECEIVED BY:**

**Firm / Agency**

Date: 1-11  
Rec'd By: KC  
No. 11-09-B

Survey One, LLC.  
P.O. Box 382  
Pendleton, OR 97801  
(541) 276-2055

RENEWAL DATE: 12/31/11