

OREGON CORNER RESTORATION FORM

Section 1,2 Township 3N
County Umatilla Date: 01/17/11

Range 29E

Corner Designation: 3N29C21

Corner common to sections 1 and 2, T3NR29E.

_____	Condition Report Only
<u>X</u> _____	Not Found
<u>X</u> _____	Remonumented
<u>X</u> _____	Unrecorded
_____	Surveyed In
<u>X</u> _____	Referenced Out


Previous Renewals / Surveys, etc.

Originally Surveyed by Gates. He set a post in a mound of earth in 1859.


Monuments and Accessories Found: (Condition and Source)

None.

Diagram

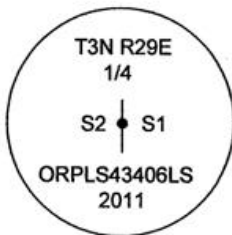

Sketch

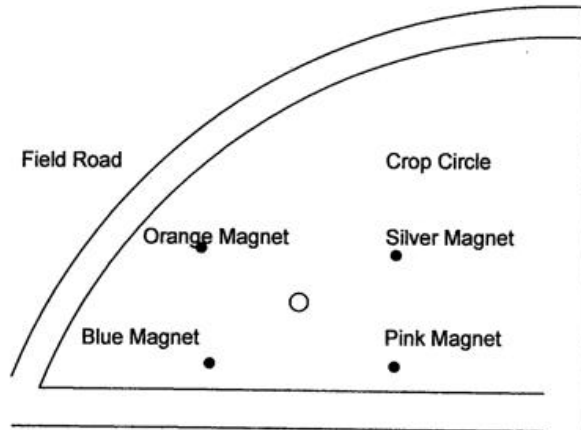

NAD 83/91
OREGON STATE PLANE NORTH
INTERNATIONAL FEET

Pumpstation



N769728.07
E8548424.37

LAT - 45° 46' 11.84353" N
LON - 119° 08' 33.98052" W

Monument (s) Set (Procedures and Description)

A 1 1/4" x 30" galvanized iron pipe with a 2 1/2" brass cap, 22" below surface, stamped as shown above.
Corner set by single proportionate method.

References Set: "Deep One" magnets by Berntsen.

- An Orange Magnet 21" deep, lies N 45° W, 15.17'.
- A Silver Magnet 24" deep, lies N 63°45' E, 16.07'.
- A Pink Magnet 23" deep, lies S 32°45' E, 17.40'.
- A Blue Magnet 22" deep, lies S 51°30' W, 18.89'.

Location and Comments

Corner lies in an existing Center Pivot field, just East of an existing pump station, Northwest of the I-84 overpass to the Old Echo Highway. There is a frontage road paralleling I-84 to just South of the corner.

Compass Declination

17° E

Surveyors Seal

REGISTERED
PROFESSIONAL
LAND SURVEYOR

Robert D. English
OREGON
JANUARY 11, 2005
ROBERT DOUGLAS ENGLISH
43406LS

RENEWAL DATE: 12/31/11

RECEIVED BY:

Date: 1-11
Rec'd By: KK
No. 11-03-R

Firm / Agency

Survey One, LLC.
P.O. Box 382
Pendleton, OR 97801
(541) 276-2055