

OREGON CORNER RESTORATION FORM

Section 4,5 Township 3N
County Umatilla Date: 08/12/10

Range 29E

Corner Designation: 3N29C9

Corner common to sections 4,5 T3NR29E.

- Condition Report Only
- Not Found
- Remonumented
- Unrecorded
- Surveyed In
- Referenced Out


Previous Renewals / Surveys, etc.

Originally Surveyed by Gates. He set a post in a mound of earth in 1859.


Monuments and Accessories Found: (Condition and Source)

PK nail.

Diagram

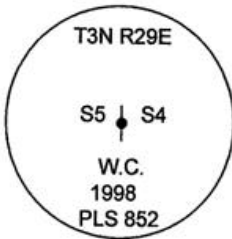

Sketch

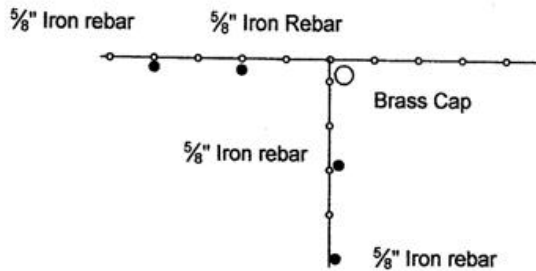

NAD 83/91
OREGON STATE PLANE NORTH
INTERNATIONAL FEET

N769382.060
E8532611.750

LAT - 45° 46' 10.99532" N
LON - 119° 12' 17.11377" W

Monument (s) Set (Procedures and Description)

None.

References Set:

- A 5/8" x 30" Iron rebar w/rpc #43406 lies N 87°57' W, 38.67'.
- A 5/8" x 30" Iron rebar w/rpc #43406 lies N 78° W, 13.17'.
- A 5/8" x 30" Iron rebar w/rpc #43406 lies S 0°50' W, 23.32'.
- A 5/8" x 30" Iron rebar w/rpc #43406 lies S 0°20' W, 51.91'.

Location and Comments

Compass Declination
17° E

Surveyors Seal

RECEIVED BY:

Date: 1-11
 Rec'd By: KE
 No. 11-09-R

Firm / Agency

Survey One, LLC.
 P.O. Box 382
 Pendleton, OR 97801
 (541) 276-2055

REGISTERED
 PROFESSIONAL
 LAND SURVEYOR

Robert D. English
 OREGON
 JANUARY 11, 2005
 ROBERT DOUGLAS ENGLISH
 43406LS

RENEWAL DATE: 12/31/11