

OREGON CORNER RESTORATION FORM

Section 10 Township 3N
County Umatilla Date: 09/10/09

Range 29E

Corner Designation: 3N29E15

1/4 corner common to sections 3 and 10, T3NR29E

- Condition Report Only
- Not Found
- Remonumented
- Unrecorded
- Surveyed In
- Referenced Out


Previous Renewals / Surveys, etc.

Originally Surveyed by Gates in 1859. He set a post in a mound of earth. Zahner in the Record of Private Surveys Book 1, Page 103 remonumented the original corner with a rock 6x11x17, with pieces of porcelain underneath. S. Haddock set a 2 1/4" Brass Cap at an East-West fence intersection with a plow berm running north.


Monuments and Accessories Found: (Condition and Source)

- A 2 1/2" B.C.
- A 5/8" Iron rebar w/opc #56295 under the fence lies S 88°00' E, 28.00'.
- A 5/8" Iron rebar w/opc #56295 under the fence lies N 89°45' W, 22.00'.
- A 5/8" Iron rebar w/opc #56295 2 feet below the surface lies S 47°30' E, 40.98'.

Diagram

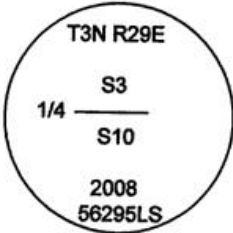

Sketch

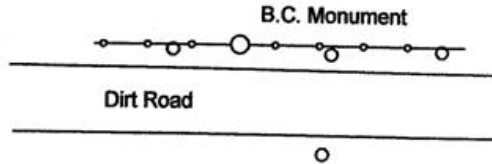

NAD 83/91
OREGON STATE PLANE NORTH
INTERNATIONAL FEET

N766909.071
E8540594.59
LAT - 45° 45' 45.30440" N
LON - 119° 10' 25.08404" W

Monument (s) Set (Procedures and Description)

None.

References Set:

A 5/8" Iron rebar w/ypc #43406 under the fence lies S 87°45' E, 52.68'.

Location and Comments

From the end of S. Ash Rd.
go east 1 mile on a gravel road
to the corner.

Compass Declination
17° E

Surveyors Seal

REGISTERED
PROFESSIONAL
LAND SURVEYOR

Robert D. English
OREGON
JANUARY 11, 2005
ROBERT DOUGLAS ENGLISH
43406LS

RENEWAL DATE: 12/31/09

RECEIVED BY:

Date: 9-09
Rec'd By: KK
No. 09-196-R

Firm / Agency

Survey One, LLC.
P.O. Box 382
Pendleton, OR 97801
(541) 276-2055