

**OREGON CORNER RESTORATION FORM**

Section 2,11 Township 3N  
County Umatilla Date: 05/21/10

Range 29E

Corner Designation: 3N29E19

Corner common to section 2 and 11 T3NR29E.



- Condition Report Only
- Not Found
- Remonumented
- Unrecorded
- Surveyed In
- Referenced Out

**Previous Renewals / Surveys, etc.**

Originally Surveyed by Gates in 1859. He set a post in a mound of earth.

**Monuments and Accessories Found: (Condition and Source)**

None. Long standing fence corner.

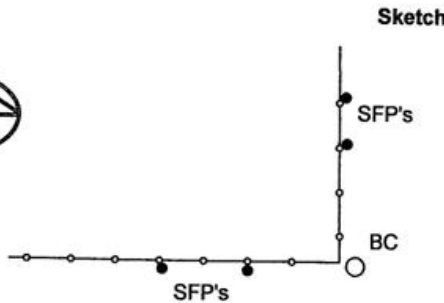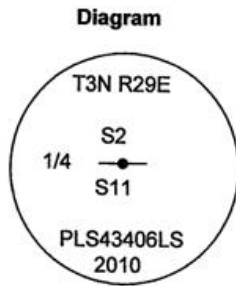

NAD 83/91  
OREGON STATE PLANE NORTH  
INTERNATIONAL FEET

N767000.37  
E8545863.97

LAT - 45° 45' 45.34016" N  
LON - 119° 09' 10.73795" W

**Monument (s) Set (Procedures and Description)**

A 1 1/4" Galvanized Iron pipe w/ 2 1/2" Brass cap stamped as shown above. Set at a long standing fence corner.

**References Set:**

- A 5/8" x 30" iron rebar w/rpc #43406 lies N 0°30' W, 63.77'.
- A 5/8" x 30" iron rebar w/rpc #43406 lies N 0°15' E, 84.45'.
- A 5/8" x 30" iron rebar w/rpc #43406 lies N 87°40' W, 22.70'.
- A 5/8" x 30" iron rebar w/rpc #43406 lies N 88°20' W, 36.50'

**Location and Comments**

The corner is North of a Potato Shed,  
Approx. 1 mile West of Echo Exit at MP  
190 +/- and 3/8 mile North of I-84..

**Compass Declination**  
17° E

**Surveyors Seal**

REGISTERED  
PROFESSIONAL  
LAND SURVEYOR

*Robert D. English*  
OREGON  
JANUARY 11, 2005  
ROBERT DOUGLAS ENGLISH  
43406LS

**RECEIVED BY:**

Date: 6-10  
Rec'd By: KL  
No. 10-94-R

**Firm / Agency**

Survey One, LLC.  
P.O. Box 382  
Pendleton, OR 97801  
(541) 276-2055

RENEWAL DATE: 12/31/11