

OREGON CORNER RESTORATION FORM

Section 2,11 Township 3N
County Umatilla Date: 05/21/10

Range 29E

Corner Designation: 3N29E19

Corner common to section 2 and 11 T3NR29E.


_____	Condition Report Only
<u> X </u>	Not Found
<u> X </u>	Remonumented
_____	Unrecorded
<u> X </u>	Surveyed In
<u> X </u>	Referenced Out

Previous Renewals / Surveys, etc.

Originally Surveyed by Gates in 1859. He set a post in a mound of earth.

Monuments and Accessories Found: (Condition and Source)

None. Long standing fence corner.

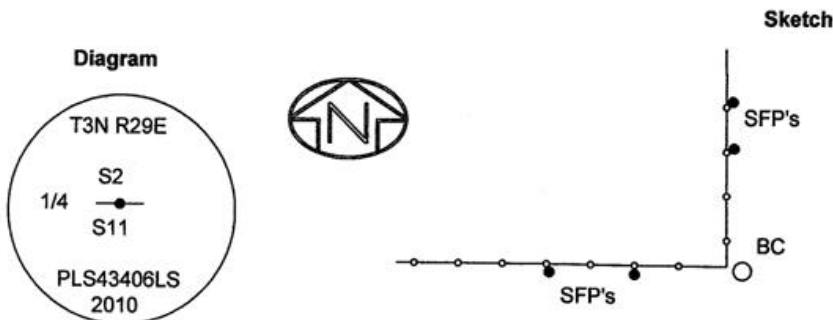

NAD 83/91
OREGON STATE PLANE NORTH
INTERNATIONAL FEET

N766995.53
E8545869.29

LAT - 45° 45' 45.29634" N
LON - 119° 09' 10.67081" W

Monument (s) Set (Procedures and Description)

A 1 1/4" X 30" galvanized iron pipe w/ 2 1/2" brass cap, stamped as shown above. Set at an ancient fence corner.

References Set:

- A 5/8" x 30" iron rebar w/rpc #43406 lies N 0°30' W, 63.77".
- A 5/8" x 30" iron rebar w/rpc #43406 lies N 0°15' E, 84.45".
- A 5/8" x 30" iron rebar w/rpc #43406 lies N 87°40' W, 22.70".
- A 5/8" x 30" iron rebar w/rpc #43406 lies N 88°20' W, 36.50".

Location and Comments

The corner is North of a Potato Shed,
Approx. 1 mile West of Echo Exit at MP
190 +/- and 3/8 mile North of I-84..

Compass Declination
17° E

Surveyors Seal

REGISTERED
PROFESSIONAL
LAND SURVEYOR

Robert D. English
OREGON
JANUARY 11, 2005
ROBERT DOUGLAS ENGLISH
43406LS

RECEIVED BY:

Date: 1-11
Rec'd By: RE
No. 11-10-R

Firm / Agency

Survey One, LLC.
P.O. Box 382
Pendleton, OR 97801
(541) 276-2055

RENEWAL DATE: 12/31/11