

OREGON CORNER RESTORATION FORM

Section 1,12 Township 3N
County Umatilla Date: 01/17/11

Range 29E

Corner Designation: 3N29E23

Corner common to section 1 and 12 T3NR29E.

- Condition Report Only
- Not Found
- Remonumented
- Unrecorded
- Surveyed In
- Referenced Out


Previous Renewals / Surveys, etc.

Originally Surveyed by Gates in 1859. He set a post in a mound of earth.


Monuments and Accessories Found: (Condition and Source)

None.

Diagram

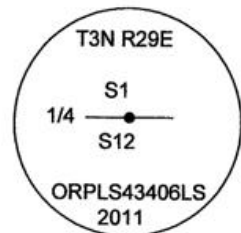

Sketch

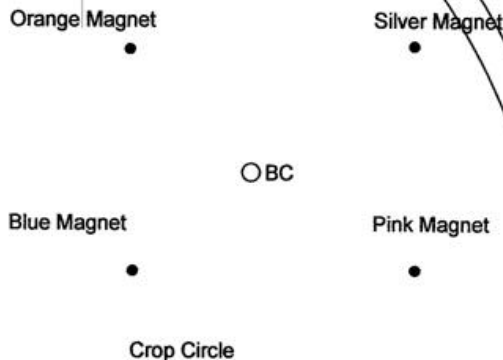

NAD 83/91
OREGON STATE PLANE NORTH
INTERNATIONAL FEET

N767139.91
E8551127.72

LAT - 45° 45' 45.84450" N
LON - 119° 07' 56.46638" W

Monument (s) Set (Procedures and Description)

A 1 1/4" X 30" galvanized Iron pipe with a 2 1/2" brass cap, 24" below surface, stamped as shown above. Corner set by single proportionate method.

References Set: "Deep One" magnets by Bermtsen.

- An Orange Magnet 23" deep, lies N 39°25' W, 21.74'.
- A Silver Magnet 23" deep, lies N 64°48' E, 15.81'.
- A Pink Magnet 23" deep, lies S 29°36' E, 19.26'.
- A Blue Magnet 23" deep, lies S 59°23' W, 17.37'

Location and Comments

The corner is North of a Potato Shed, Northwest of the intersection of I-84 and the Old Echo Hwy. Follow frontage road on the North side of I-84 to near the proximity of the 1/4 corner to Sections 11 and 12 and follow field roads around circles.

Compass Declination

17° E

Surveyors Seal

REGISTERED
PROFESSIONAL
LAND SURVEYOR

Robert D. English
OREGON
JANUARY 11, 2005
ROBERT DOUGLAS ENGLISH
43406LS

RECEIVED BY:

Date: 1-11
Rec'd By: KK
No. 11-04-R

Firm / Agency

Survey One, LLC.
P.O. Box 382
Pendleton, OR 97801
(541) 276-2055

RENEWAL DATE: 12/31/11