

OREGON CORNER RESTORATION FORM

Section 5
County Umatilla

Township 3N
Date: 08/31/09

Range 29E

Corner Designation: 3N29E9

Corner common to sections 4,5,8 and 9, T3NR29E.

- Condition Report Only
- Not Found
- Remonumented
- Unrecorded
- Surveyed In
- Referenced Out


Previous Renewals / Surveys, etc.

Originally Surveyed by N.H. Gates in 1859. He set a post in a mound of earth.
 Arnold set an unmarked basalt stone 8x7x6 inches over the original stake in the survey recorded in book 1, page 163.
 Kimbrell deposited stone coal under this stone in the survey recorded in book 2, page 582.
 Staebler set a brass cap at the position of a stone he says was reset by the highway department in survey no. H-B-4


Monuments and Accessories Found: (Condition and Source)

Found A 2.5" B.C.

Diagram

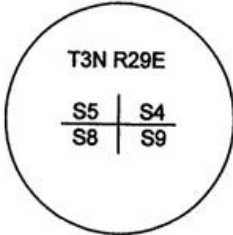

Sketch

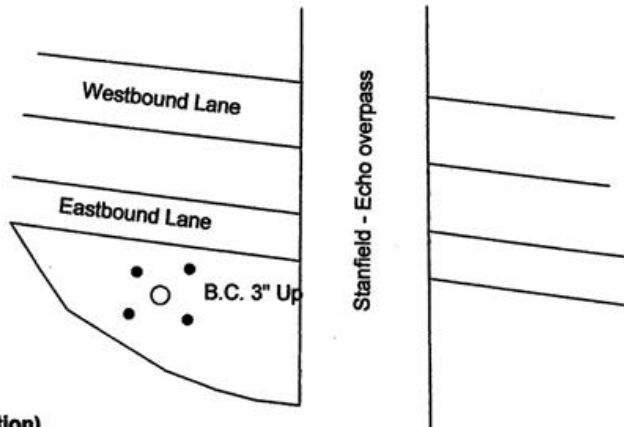

NAD 83/91
OREGON STATE PLANE NORTH
INTERNATIONAL FEET

N766745.53
E8532719.81

LAT - 45° 45' 44.94668" N
LON - 119° 12' 16.17905" W

Monument (s) Set (Procedures and Description)

None.

References Set:

- A 3/8" x 30" Iron rebar w/ypc #43406 lies S 61°00' E, 9.09'.
- A 3/8" x 30" Iron rebar w/ypc #43406 lies N 55°00' E, 9.61'.
- A 3/8" x 30" Iron rebar w/ypc #43406 lies N 41°00' W, 10.65'.
- A 3/8" x 30" Iron rebar w/ypc #43406 lies S 58°00' W, 13.21'.

Location and Comments

The corner is off the Southwest corner of the I-84 Overpass to Stanfield-Echo.

Compass Declination

17° E

Surveyors Seal

REGISTERED
PROFESSIONAL
LAND SURVEYOR

Robert D. English
 OREGON
 JANUARY 4, 2005
 ROBERT DOUGLAS ENGLISH
 43406LS

RENEWAL DATE: 12/31/09

RECEIVED BY:

Date: 10-09
 Rec'd By: KE
 No. 09-1462

Firm / Agency

Survey One, LLC.
 P.O. Box 382
 Pendleton, OR 97801
 (541) 276-2055