

OREGON CORNER RESTORATION FORM

Section 7 Township 3N
County Umatilla Date: 09/25/09

Range 29E

Corner Designation: 3N29G1

1/4 corner common to sections 7, T3NR29E, 12,
T3NR28E.

- Condition Report Only
- Not Found
- Remonumented
- Unrecorded
- Surveyed In
- Referenced Out

Previous Renewals / Surveys, etc.

Originally Surveyed by Gates in 1859. He set a post in a mound of earth.


Monuments and Accessories Found: (Condition and Source)

None.

Diagram



Sketch

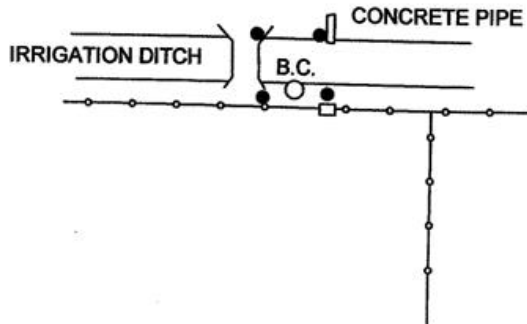

NAD 83/91
OREGON STATE PLANE NORTH
INTERNATIONAL FEET

N763817.58
E8521520.56

LAT - 45° 45' 17.78575" N
LON - 119° 14' 54.77271" W

Monument (s) Set (Procedures and Description)

Set a 2 1/2" Brass cap on a 1 1/8" x 30" galvanized iron pipe 12 inches below the surface by single proportionate measure.

References Set:

- A 5/8" Iron rebar w/rpc #43406 lies N 33°00' W, 14.00'.
- A 5/8" Iron rebar w/rpc #43406 lies N 27°15' E, 12.67'.
- A 5/8" Iron rebar w/rpc #43406 lies S 81°30' W, 8.96'.
- A 5/8" Iron rebar w/rpc #43406 lies S 74°45' E, 10.00'.

Location and Comments

From the intersection of Whitehouse
Road and Andrews Road, go .5 miles
North along a field road.

Compass Declination
17° E

Surveyors Seal

REGISTERED
PROFESSIONAL
LAND SURVEYOR

Robert D. English
OREGON
JANUARY 11, 2005
ROBERT DOUGLAS ENGLISH
43406LS

RENEWAL DATE: 12/31/09

RECEIVED BY:

Date: 10-09
Rec'd By: RK
No. 09-146R

Firm / Agency

Survey One, LLC.
P.O. Box 382
Pendleton, OR 97801
(541) 276-2055