

OREGON CORNER RESTORATION FORM

Section 7 Township 3N
County Umatilla Date: 09/25/09

Range 29E

Corner Designation: 3N29G1

1/4 corner common to sections 7, T3NR29E, 12, T3NR28E.

_____	Condition Report Only
X _____	Not Found
X _____	Remonumented
_____	Unrecorded
X _____	Surveyed In
X _____	Referenced Out

Previous Renewals / Surveys, etc.

Originally Surveyed by Gates in 1859. He set a post in a mound of earth.


Monuments and Accessories Found: (Condition and Source)

None.

Diagram



Sketch

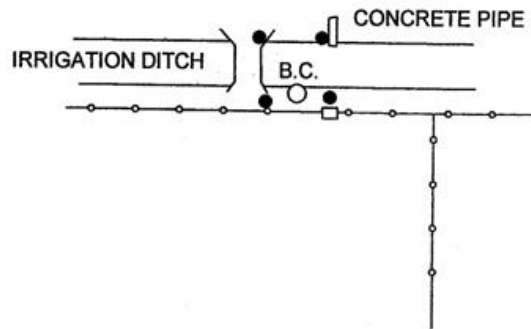

NAD 83/91
OREGON STATE PLANE NORTH
INTERNATIONAL FEET

N763812.74
E8521525.88

LAT - 45° 45' 17.74198" N
LON - 119° 14' 54.70550" W

Monument (s) Set (Procedures and Description)

Set a 2 1/2" Brass cap on a 1 1/4" x 30" galvanized iron pipe, 12 inches below the surface by single proportionate measure.

References Set:

- A 5/8" Iron rebar w/rpc #43406 lies N 33°00' W, 14.00'.
- A 5/8" Iron rebar w/rpc #43406 lies N 27°15' E, 12.67'.
- A 5/8" Iron rebar w/rpc #43406 lies S 81°30' W, 8.96'.
- A 5/8" Iron rebar w/rpc #43406 lies S 74°45' E, 10.00'.

Location and Comments

From the intersection of Whitehouse Road and Andrews Road, go .5 miles North along a field road.

Compass Declination
17° E

Surveyors Seal

REGISTERED
PROFESSIONAL
LAND SURVEYOR

Robert D. English
OREGON
JANUARY II, 2005
ROBERT DOUGLAS ENGLISH
43406LS

RENEWAL DATE: 12/31/09

RECEIVED BY:

Date: 1-11
Rec'd By: KE
No. 11-12-R

Firm / Agency

Survey One, LLC.
P.O. Box 382
Pendleton, OR 97801
(541) 276-2055