

OREGON CORNER RESTORATION FORM

Section 7,8
County Umatilla

Township 3N
Date: 08/18/09

Range 29E

Corner Designation: 3N29G5

1/4 Corner common to sections 7 and 8, T3N29E.

- Condition Report Only
- Not Found
- Remonumented
- Unrecorded
- Surveyed In
- Referenced Out


Previous Renewals / Surveys, etc.

Originally Surveyed by N.H. Gates in 1859. He set a post in a mound of earth. Survey Q-511-Ax records finding a stone at this corner location.


Monuments and Accessories Found: (Condition and Source)

A stone.

Diagram

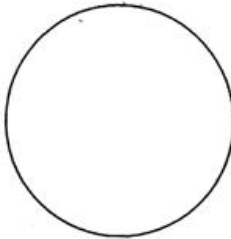

Sketch

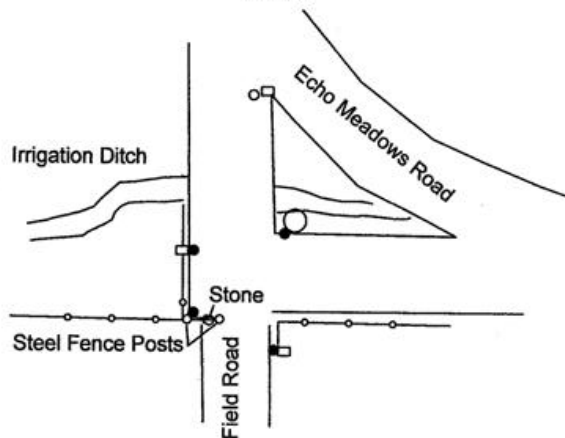

NAD 83/91
OREGON STATE PLANE NORTH
INTERNATIONAL FEET

N763936.58
E8527371.21

LAT - 45° 45' 18.06237" N
LON - 119° 13' 32.24696" W

Monument (s) Set (Procedures and Description)

None.

References Set:

- A 3/8" x 30" Iron rebar w/ypc #43406 lies N 45°00' E, 40.03'.
- A 3/8" x 30" Iron rebar w/ypc #43406 lies S 30°00' W, 24.82'.
- A 3/8" x 30" Iron rebar w/ypc #43406 lies N 79°00' W, 3.52'.
- A 3/8" x 30" Iron rebar w/ypc #43406 lies S 53°00' W, 32.39'.

Location and Comments

The corner is .5 miles south of the intersection of Echo Meadows Road and Correa Lane.

Compass Declination
17° E

Surveyors Seal

REGISTERED
PROFESSIONAL
LAND SURVEYOR

Robert D. English
OREGON
JANUARY 11, 2005
ROBERT DOUGLAS ENGLISH
43406LS

RECEIVED BY:

Date: 1-11
Rec'd By: KE
No. 11-12-R

Firm / Agency

Survey One, LLC.
P.O. Box 382
Pendleton, OR 97801
(541) 276-2055

RENEWAL DATE: 12/31/09