

OREGON CORNER RESTORATION FORM

Section 9,16
County Umatilla

Township 3N
Date: 08/18/09

Range 29E

Corner Designation: 3N29J11

1/4 Corner common to sections 9 and 16, T3NR29E.

- Condition Report Only
- Not Found
- Remonumented
- Unrecorded
- Surveyed In
- Referenced Out

Previous Renewals / Surveys, etc.

Originally Surveyed by N.H. Gates in 1859. He set a post in a mound of earth.

A 1916 Railroad map call the corner a "rock".

PLS 933 set a Brass Cap at the position of a found wagon axle in Survey S-158-C.

PLS 852 set a 2 1/4" Brass Cap at the position of a found stone, coal, and broken pottery. May, 2008.


Monuments and Accessories Found: (Condition and Source)

A 2.5" B.C.


A 5/8" Iron rebar w/rpc #852 @ Power Pole lies N 4° 00' W, 26.38'.

A 3/4" Iron rebar lies S 89° 00' E, 16.65'.

Diagram

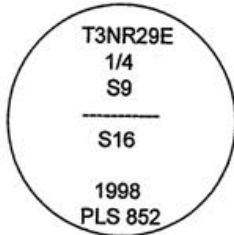

Sketch

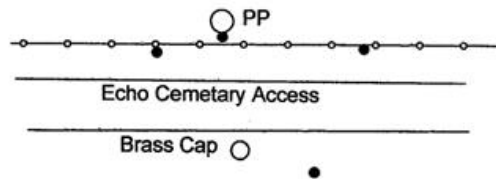

NAD 83/91
OREGON STATE PLANE NORTH
INTERNATIONAL FEET

N761497.315
E8535446.56

LAT - 45° 44' 52.70972" N
LON - 119° 11' 38.92484" W

Monument (s) Set (Procedures and Description)

None.

References Set:

A 5/8" x 30" Iron rebar w/ypc #43406 @ fence post lies N 33°45' E, 25.87'.

A 5/8" x 30" Iron rebar w/ypc #43406 @ fence post lies N 48°00' W, 32.56'.

Location and Comments

The corner is located approx. 300 feet inside the entrance to the echo cemetary, and on the south edge of the road.

Compass Declination

17° E

Surveyors Seal

REGISTERED
PROFESSIONAL
LAND SURVEYOR

Robert D. English
OREGON
JANUARY 11, 2005
ROBERT DOUGLAS ENGLISH
43406LS

RECEIVED BY:

Date: 1-11
Rec'd By: RB
No. 11-13-R

Firm / Agency

Survey One, LLC.
P.O. Box 382
Pendleton, OR 97801
(541) 276-2055

RENEWAL DATE: 12/31/09