

OREGON CORNER RESTORATION FORM

Section 11,14 Township 3N
County Umatilla Date: 05/06/10

Range 29E

Corner Designation: 3N29J19

Corner common to section 11 and 14 T3NR29E.

Condition Report Only
 Not Found
 Remonumented
 Unrecorded
 Surveyed In
 Referenced Out

Previous Renewals / Surveys, etc.



Originally Surveyed by Gates in 1859. He set a post in a mound of earth.

Monuments and Accessories Found: (Condition and Source)

None.

Sketch

Diagram

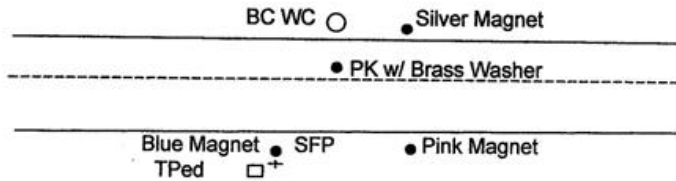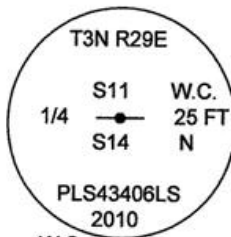

W.C.
NAD 83/91
OREGON STATE PLANE NORTH
INTERNATIONAL FEET

N761742.85
E8545973.91

LAT - 45° 44' 53.42711" N
LON - 119° 09' 10.43068" W

Monument (s) Set (Procedures and Description)

A pk nail w/ 1 1/2" Brass washer stamped 43406LS with WC to North. I set this corner by Single Proportionate Method.

References Set: "Deep One" magnets by Berntsen.

A Silver magnet 12" deep lies N 48°50' E, 29.47'.

A Pink magnet 18" deep lies S 36° E, 38.68'.

A Blue magnet 18" deep lies S 37°50' W, 49.10'.

1 1/2" x 30" Galvanized iron pipe with a 2 1/2" Brass cap monument Witness Corner, stamped as shown above, lies N 0°5' E, 25.00'

Location and Comments

The corner is 1.5 miles West of the intersection of Coppinger Lane and Hwy. 320. near CL of Hwy. 320.

Compass Declination

17° E

Surveyors Seal

REGISTERED
PROFESSIONAL
LAND SURVEYOR

Robert Douglas English
OREGON
JANUARY 11, 2005
ROBERT DOUGLAS ENGLISH
43406LS

RECEIVED BY:

Date: 1-11
Rec'd By: KK
No. 11-13-R

Firm / Agency

Survey One, LLC.
P.O. Box 382
Pendleton, OR 97801
(541) 276-2055

RENEWAL DATE: 12/31/11