

**OREGON CORNER RESTORATION FORM**

Section 12,13 Township 3N  
County Umatilla Date: 05/06/10

Range 29E

Corner Designation: 3N29J23

Corner common to section 12 and 13 T3NR29E.

- Condition Report Only
- Not Found
- Remonumented
- Unrecorded
- Surveyed In
- Referenced Out


Previous Renewals / Surveys, etc.

Originally Surveyed by Gates in 1859. He set a post in a mound of earth.


Monuments and Accessories Found: (Condition and Source)

None.

**Diagram**

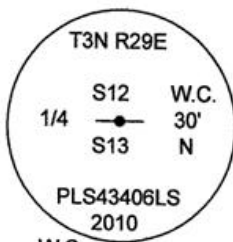

**Sketch**

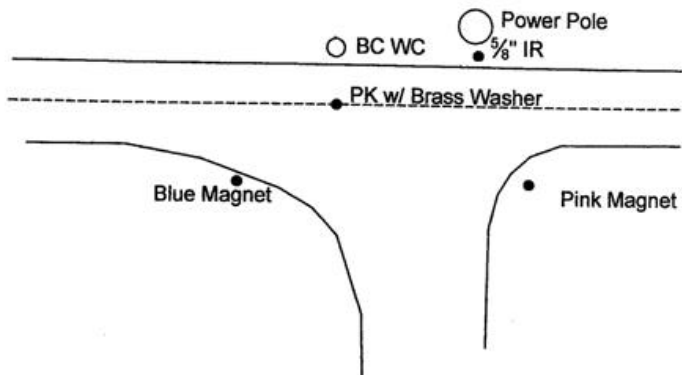

NAD 83/91  
OREGON STATE PLANE NORTH  
INTERNATIONAL FEET

N761823.55  
E8551238.34

LAT - 45° 44' 53.33457" N  
LON - 119° 07' 56.17579" W

Monument (s) Set (Procedures and Description)

A pk nail w/ 1 1/2" Brass washer stamped 43406LS, w/ WC to North. Set by single proportionate Method.

References Set: "Deep One" Magnets by Berntsen.

A 5/8" x 30" Iron rebar w/rpc #43406 lies N 32°30' E, 32.99'.

A Pink magnet 18" deep lies S 40°20' E, 37.39'.

A Blue magnet 18" deep lies S 36° W, 35.09'.

1 1/2" x 30" Galvanized iron pipe with a 2 1/2" Brass cap monument Witness Corner, stamped as shown above, lies N 0°15' W, 30.00', 6" below the surface.

Location and Comments

The corner is 0.5 miles West of the intersection of Coppinger Lane and Hwy. 320. on Hwy. 320.

Compass Declination  
17° E

Surveyors Seal

REGISTERED  
PROFESSIONAL  
LAND SURVEYOR

*Robert D. English*  
OREGON  
JANUARY 11, 2005  
ROBERT DOUGLAS ENGLISH  
43406LS

RECEIVED BY:

Date: 6-10  
Rec'd By: RE  
No. 10-99-R

Firm / Agency

Survey One, LLC.  
P.O. Box 382  
Pendleton, OR 97801  
(541) 276-2055

RENEWAL DATE: 12/31/11