

OREGON CORNER RESTORATION FORM

Section 13 Township 3N Range 29E
County Umatilla Date: 08/18/09

Corner Designation: 3N29R7

Corner common to section 12,13, T3NR29E, and section 7,18, T3NR30E.

Condition Report Only
Not Found
 Remonumented
Unrecorded
 Surveyed In
Referenced Out


Previous Renewals / Surveys, etc.

Originally Surveyed by David P. Thompson in 1859. He set a post in a mound of earth.


Monuments and Accessories Found: (Condition and Source)

A bridge spike from survey 01-146-B lies N 20°00' E, 18.09'.

Diagram

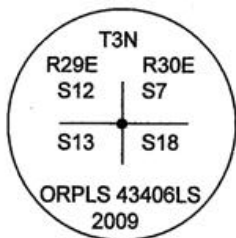

Sketch

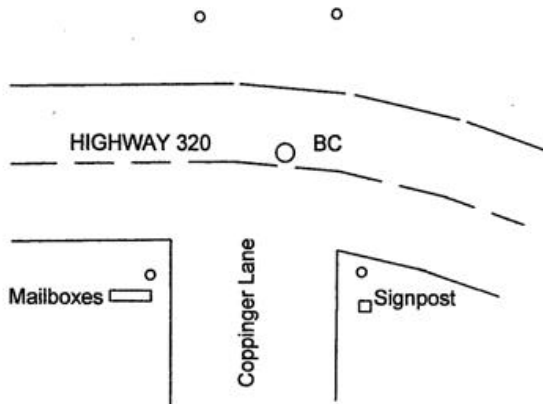

NAD 83/91
OREGON STATE PLANE NORTH
INTERNATIONAL FEET

N761872.88
E8553864.25

LAT - 45° 44' 53.39698" N
LON - 119° 07' 19.14529" W

Monument (s) Set (Procedures and Description)

Set A 1"x30" flared galvanized iron pipe with a 2 1/2" B.C. by best fit between the northeast corner of the township and the northeast corner of S 25, and the best fit to Coppinger Lane and Highway 320.

References Set:

- A 5/8" x 30" Iron rebar w/ypc #43406 lies S 13°45' E, 78.53'
- A 5/8" x 30" Iron rebar w/ypc #43406 lies S 63°00' W, 51.26'
- A 5/8" x 30" Iron rebar w/ypc #43406 lies N 50°15' W, 34.09'

Location and Comments

The corner is in the intersection of Coppinger Lane and Highway 320.

Compass Declination
17° E

Surveyors Seal

REGISTERED
PROFESSIONAL
LAND SURVEYOR

Robert D. English
OREGON
JANUARY 11, 2005
ROBERT DOUGLAS ENGLISH
43406LS

RECEIVED BY:

Firm / Agency

Survey One, LLC.
P.O. Box 382
Pendleton, OR 97801
(541) 276-2055

RENEWAL DATE: 12/31/09

Date: 1-11
Rec'd By: RE
No. 11-15-2