

**OREGON CORNER RESTORATION FORM**

Section 13 Township 3N Range 29E  
County Umatilla Date: 08/18/09

Corner Designation: 3N29L25

1/4 Corner common to section 13, T3NR29E, and section 18, T3NR30E.

- Condition Report Only
- Not Found
- Remonumented
- Unrecorded
- Surveyed In
- Referenced Out


**Previous Renewals / Surveys, etc.**

Originally Surveyed by David P. Thompson in 1859. He set a post in a mound of earth.


**Monuments and Accessories Found: (Condition and Source)**

None

**Diagram**

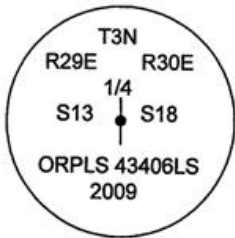

**Sketch**

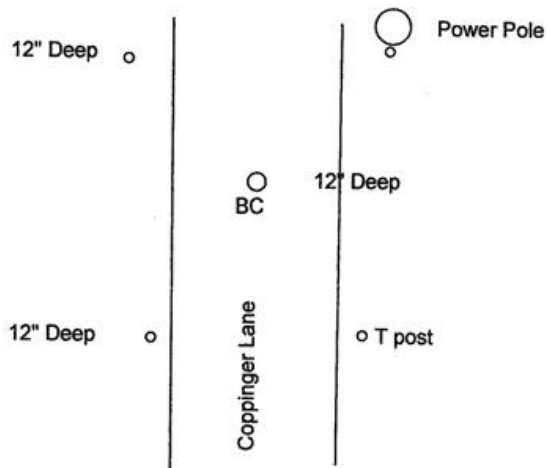

NAD 83/91  
OREGON STATE PLANE NORTH  
INTERNATIONAL FEET

N759226.37  
E8553918.17

LAT - 45° 44' 27.26287" N  
LON - 119° 07' 19.02149" W

**Monument (s) Set (Procedures and Description)**

Set A 1"x30" flared galvanized iron pipe with a 2 1/2" B.C. by best fit between the northeast corner of the township and the northeast corner of S 25, and the best fit to Coppinger Lane and old plow berm to the east.

**References Set:**

- A 5/8" x 30" Iron rebar w/ypc #43406 lies N 23°00' E, 52.84'
- A 5/8" x 30" Iron rebar w/ypc #43406 lies S 8°30' E, 126.59'
- A 5/8" x 30" Iron rebar w/ypc #43406 lies S 15°45' W, 34.09'
- A 5/8" X30" Iron rebar w/ypc #43406 lies N 29°30' W, 19.90'

**Location and Comments**

The corner is .5 miles south of the intersection of Coppinger Lane and Highway 320.

**Compass Declination**  
17° E

**Surveyors Seal**

REGISTERED  
PROFESSIONAL  
LAND SURVEYOR

*Robert D. English*  
OREGON  
JANUARY 11, 2005  
ROBERT DOUGLAS ENGLISH  
43406LS

**RECEIVED BY:**

Date: 1-11  
Rec'd By: KE  
No. 11-14-R

**Firm / Agency**

Survey One, LLC.  
P.O. Box 382  
Pendleton, OR 97801  
(541) 276-2055

RENEWAL DATE: 12/31/09