

**OREGON CORNER RESTORATION FORM**

Section 17,18  
County Umatilla

Township 3N  
Date: 03/09/10

Range 29E

Corner Designation: 3N29L5

Corner common to sections 17,18 T3NR29E.

- Condition Report Only
- Not Found
- Remonumented
- Unrecorded
- Surveyed In
- Referenced Out


**Previous Renewals / Surveys, etc.**

Originally Surveyed by Gates. He set a post in a mound of earth in 1859.  
Survey I-157-B records setting a 3/4" iron pipe here.  
Haddock found an iron pipe fitting the description in LCR 02-184-B, he says the pipe may have been moved.


**Monuments and Accessories Found: (Condition and Source)**

A 3/4" Iron pipe fitting the description laying on top of the ground out of position.

Diagram

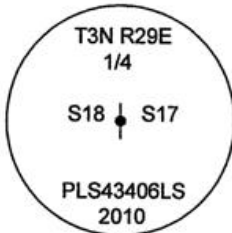

Sketch

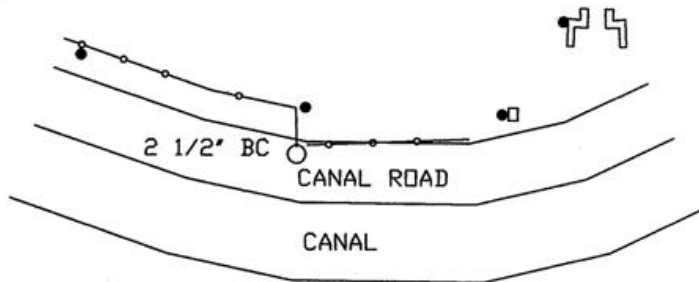

NAD 83/91  
OREGON STATE PLANE NORTH  
INTERNATIONAL FEET

N758685.03  
E8527439.43

LAT - 45° 44' 26.21008" N  
LON - 119° 13' 32.45316" W

**Monument (s) Set (Procedures and Description)**

Set a 1 1/4" x 30" galvanized iron pipe with a 2 1/2" brass cap, stamped as shown above.  
Monument position calculated by single proportionate measure. Confirmed by old fence intersection.  
Fence buried in Canal Road embankment and short fence to North.

**References Set:**

- A 5/8"x30" Iron rebar w/rpc #43406 lies N 60°30' W, 98.97', at a Steel fence post along the fence.
- A 5/8"x30" Iron rebar w/rpc #43406 lies N 1°40' E, 19.25', at a fence corner.
- A 5/8"x30" Iron rebar w/rpc #43406 lies N 84° E, 99.39', at a wooden fence post.
- A 5/8"x30" Iron rebar w/rpc #43406 lies N 70°50' E, 119.35', at a steel fence post near the Conc. Irr. Box.

**Location and Comments**

The corner is 0.25 miles North from the intersection of Hwy. 320 and Echo Meadows Road, then West on the Canal maintenance road 0.25 miles.

**Compass Declination**  
17° E

**Surveyors Seal**

REGISTERED  
PROFESSIONAL  
LAND SURVEYOR

*Robert Douglas English*  
OREGON  
JANUARY 11, 2005  
ROBERT DOUGLAS ENGLISH  
43406LS

**RECEIVED BY:**

Date: 1-11  
Rec'd By: KE  
No. 15-14-R

**Firm / Agency**

Survey One, LLC.  
P.O. Box 382  
Pendleton, OR 97801  
(541) 276-2055

RENEWAL DATE: 12/31/11