

OREGON CORNER RESTORATION FORM

Section 15,22 Township 3N
County Umatilla Date: 05/03/10

Range 29E

Corner Designation: 3N29N15

Corner common to section 14 and 23 T3NR29E.

- Condition Report Only
- Not Found
- Remonumented
- Unrecorded
- Surveyed In
- Referenced Out

Previous Renewals / Surveys, etc.



Originally Surveyed by Gates in 1859. He set a post in a mound of earth.

Monuments and Accessories Found: (Condition and Source)

None.

Sketch

Diagram

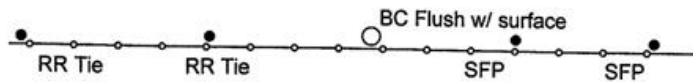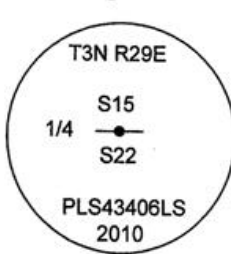

NAD 83/91
OREGON STATE PLANE NORTH
INTERNATIONAL FEET

N756289.62
E8540796.19

LAT - 45° 44' 00.43603" N
LON - 119° 10' 24.69325" W

Monument (s) Set (Procedures and Description)

A 1 1/2" x 30" galvanized iron pipe with a 2 1/2" Brass cap, stamped as shown above. Set near fence line at proportional distance. The fence is very old and delineates lines of occupation. There are old plow berms that are nearly 2' high along this fence line and native pasture land to the South. We held the fence line, in spite of the fact that proportional line would move the position 44' to the North into the farmed field.

References Set: Deep One Magnets by Berntsen.

- A 5/8" x 30" Iron rebar w/rpc #43406 lies S 89°30' E, 28.93'.
- An Orange magnet, 6" deep, lies N 89°40' E, 58.70'.
- A pk and Brass washer #43406 lies S 86°20' W, 28.58'.
- A pk and Brass washer #43406 lies N 89°30' W, 60.38'.

Location and Comments

The corner is 1 mile South and 2.5 miles West of the intersection of Coppinger Lane and Hwy. 320.

Compass Declination

17° E

Surveyors Seal

REGISTERED
PROFESSIONAL
LAND SURVEYOR

Robert Douglas English
 OREGON
 JANUARY 11, 2005
 ROBERT DOUGLAS ENGLISH
 43406LS

RECEIVED BY:

Date: 6-10
 Rec'd By: KE
 No. 10-101-R

Firm / Agency

Survey One, LLC.
 P.O. Box 382
 Pendleton, OR 97801
 (541) 276-2055

RENEWAL DATE: 12/31/11