

**OREGON CORNER RESTORATION FORM**

Section 13,24 Township 3N  
County Umatilla Date: 04/28/10

Range 29E

Corner Designation: 3N29N23

Corner common to section 13 and 24 T3NR29E.

Condition Report Only  
 Not Found  
 Remonumented  
 Unrecorded  
 Surveyed In  
 Referenced Out


**Previous Renewals / Surveys, etc.**

Originally Surveyed by Gates in 1859. He set a post in a mound of earth.


**Monuments and Accessories Found: (Condition and Source)**

None. Corner re-established by single proportionate method holding the East-West line between monuments and an ancient North-South fence line. Found decomposed wooden fence post when excavating for the monument. This fence has been in existence and held as apparent lines of occupation for a long time.

**Diagram**

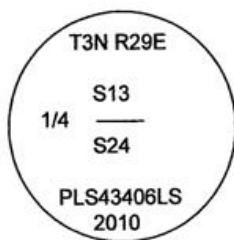

**Sketch**

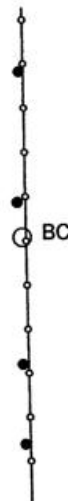

NAD 83/91  
OREGON STATE PLANE NORTH  
INTERNATIONAL FEET

N756523.84  
E8551339.34

LAT - 45° 44' 01.012586" N  
LON - 119° 07' 56.01689" W

**Monument (s) Set (Procedures and Description)**

1 1/2" x 30" Galvanized iron pipe with a 2 1/2" Brass cap monument, flush with ground, stamped as shown above.

**References Set:**

- A 5/8" x 30" Iron rebar w/rpc #43406 lies S 02° W, 15.78' at base of wooden fence post.
- A 5/8" x 30" Iron rebar w/rpc #43406 lies S 0° E, 47.44' at base of steel fence post.
- A 5/8" x 30" Iron rebar w/rpc #43406 lies N 0°20' W, 9.90' at base of steel fence post.
- A 5/8" x 30" Iron rebar w/rpc #43406 lies N 0°18' E, 36.27' at base of steel fence post.

**Location and Comments**

The corner is 1 mile South and 0.5 miles West of the intersection of Coppinger Lane and Hwy. 320.

**Compass Declination**

17° E

**Surveyors Seal**

REGISTERED  
PROFESSIONAL  
LAND SURVEYOR

*Robert D. English*  
OREGON  
JANUARY 11, 2005  
ROBERT DOUGLAS ENGLISH  
43406LS

**RECEIVED BY:**

Date: 5-10  
Rec'd By: KK  
No. 10-83-R

**Firm / Agency**

Survey One, LLC.  
P.O. Box 382  
Pendleton, OR 97801  
(541) 276-2055

RENEWAL DATE: 12/31/11