

OREGON CORNER RESTORATION FORM

Section 18,19 Township 3N
County Umatilla Date: 01/17/11

Range 29E

Corner Designation: 3N29N3

Corner common to sections 18 and 19, T3NR29E.

- Condition Report Only
- Not Found
- Remonumented
- Unrecorded
- Surveyed In
- Referenced Out


Previous Renewals / Surveys, etc.

Originally Surveyed by N.H. Gates in 1859. He set a post in a mound of earth.


Monuments and Accessories Found: (Condition and Source)

None.

Diagram

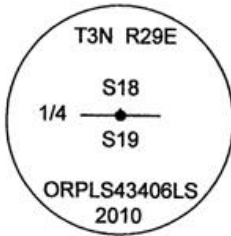

Sketch

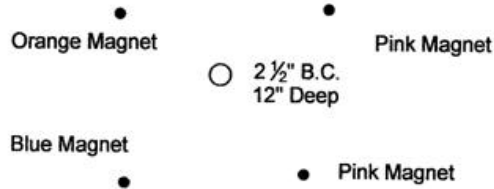

NAD 83/91
OREGON STATE PLANE NORTH
INTERNATIONAL FEET

N755982.51
E8524835.67

LAT - 45° 43' 59.93048" N
LON - 119° 14' 97.51616" W

Monument (s) Set (Procedures and Description)

A 1"x30" galvanized iron pipe with a 2 1/2" brass cap, 22" below surface. Stamped as shown above. Corner set by single proportionate method.

References Set: "Deep One" magnets by Berntsen.

- An Orange Magnet 22" deep, lies N 34°27'07" W, 18.68'.
- A Silver Magnet 21" deep, lies N 34°13'15" E, 18.87'.
- A Pink Magnet 22" deep, lies S 44°43'46" E, 23.87'.
- A Blue Magnet 22" deep, lies S 37°14'17" W, 20.87'.

Location and Comments

The corner is .5 miles West of the intersection of Hwy 320 and Snow Road, North of the Eagle Farms Shops and approx. 600' West of a center pivot.

Compass Declination

17° E

Surveyors Seal

REGISTERED
PROFESSIONAL
LAND SURVEYOR

Robert D. English
OREGON
JANUARY 11, 2005
ROBERT DOUGLAS ENGLISH
43406LS

RECEIVED BY:

Date: 1-11
Rec'd By: *KK*
No. 11-05-R

Firm / Agency

Survey One, LLC.
P.O. Box 382
Pendleton, OR 97801
(541) 276-2055

RENEWAL DATE: 12/31/11