

OREGON CORNER RESTORATION FORM

Section 21,22 Township 3N
County Umatilla Date: 08/12/10

Range 29E

Corner Designation: 3N29P13

Corner common to sections 21,22 T3NR29E.

_____	Condition Report Only
<u> X </u>	Not Found
<u> X </u>	Remonumented
_____	Unrecorded
<u> X </u>	Surveyed In
<u> X </u>	Referenced Out


Previous Renewals / Surveys, etc.

Originally Surveyed by Gates. He set a post in a mound of earth in 1859.


Monuments and Accessories Found: (Condition and Source)

None.

Diagram

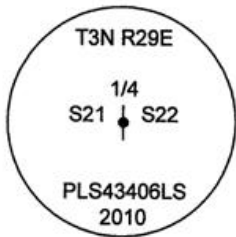

Sketch

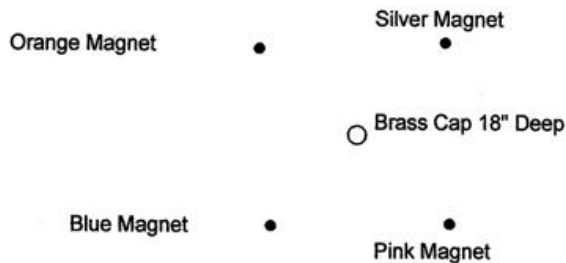

NAD 83/91
OREGON STATE PLANE NORTH
INTERNATIONAL FEET

N753619.60
E8538178.57

LAT - 45° 43' 34.50597" N
LON - 119° 11' 02.21261" W

Monument (s) Set (Procedures and Description)

A 1 1/2" x 30" galvanized iron pipe w/ a 2 1/2" brass capped monument 18" below the surface, stamped as shown above. Set by single proportion.

References Set: "Deep One" magnets by Berntsen.

- An Orange magnet 20" deep lies N 64°30' W, 17.50'.
- A Silver magnet 20" deep lies N 28°20' E, 14.73'.
- A Pink magnet 20" deep lies S 54°30' E, 18.85'.
- A Blue magnet 20" deep lies S 21°30' W, 17.30'.

Location and Comments

Corner is in alfalfa field and circle irrigated field approx. 1/4 mile W. of John Ramos' house on Old Reith Road.

Compass Declination

17° E

Surveyors Seal

REGISTERED
PROFESSIONAL
LAND SURVEYOR

Robert D. English
OREGON
JANUARY 11, 2005
ROBERT DOUGLAS ENGLISH
43406LS

RENEWAL DATE: 12/31/11

RECEIVED BY:

Date: 1-11
Rec'd By: KE
No. 11-16-R

Firm / Agency

Survey One, LLC.
P.O. Box 382
Pendleton, OR 97801
(541) 276-2055