

OREGON CORNER RESTORATION FORM

Section 22,23 Township 3N
County Umatilla Date: 08/12/10

Range 29E

Corner Designation: 3N29P17

Corner common to sections 22,23 T3NR29E.

_____	Condition Report Only
_____X_____	Not Found
_____X_____	Remonumented
_____	Unrecorded
_____X_____	Surveyed In
_____X_____	Referenced Out


Previous Renewals / Surveys, etc.

Originally Surveyed by Gates. He set a post in a mound of earth in 1859.


Monuments and Accessories Found: (Condition and Source)

None.

Diagram

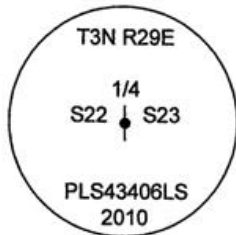

Sketch

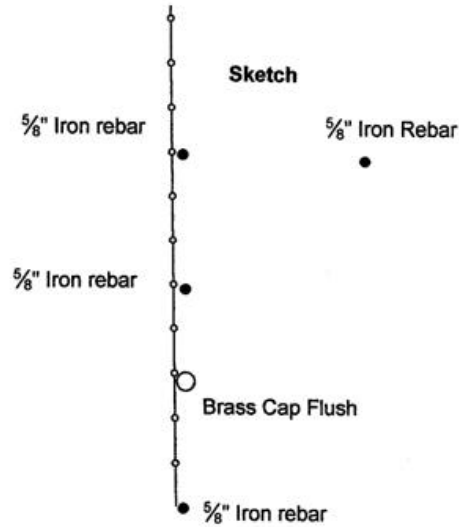

NAD 83/91
OREGON STATE PLANE NORTH
INTERNATIONAL FEET

N753735.54
E8543462.13

LAT - 45° 43' 34.79406" N
LON - 119° 09' 47.71533" W

Monument (s) Set (Procedures and Description)

A 1 1/2" x 30" Galvanized iron pipe w/ a 2 1/2" Brass capped monument flush with the surface, stamped as shown above. Set by single proportionate distance and in the fence line.

References Set:

- A 5/8" x 30" Iron rebar w/rpc #43406 lies N 3°15' W, 20.44'.
- A 5/8" x 30" Iron rebar w/rpc #43406 lies N 2°30' W, 35.06'.
- A 5/8" x 30" Iron rebar w/rpc #43406 lies N 59°10' E, 47.56'.
- A 5/8" x 30" Iron rebar w/rpc #43406 lies S 0°12' W, 54.45'.

Location and Comments

Corner is in N-S fenceline approx.
1/4 mile East of Ramos Pit on Old Reith-
Echo Hwy.

Compass Declination
17° E

Surveyors Seal

REGISTERED
PROFESSIONAL
LAND SURVEYOR

Robert D. English
OREGON
JANUARY II, 2005
ROBERT DOUGLAS ENGLISH
43406LS

RECEIVED BY:

Date: 8-10
Rec'd By: RE
No. 10-142-R

Firm / Agency

Survey One, LLC.
P.O. Box 382
Pendleton, OR 97801
(541) 276-2055

RENEWAL DATE: 12/31/11