

**OREGON CORNER RESTORATION FORM**

Section 30  
County Umatilla

Township 3N  
Date: 09/15/09

Range 29E

Corner Designation: 3N29V1

Corner common to sections 30,31, T3NR29E, and 25, 36, T3NR28E.

- Condition Report Only
- Not Found
- Remonumented
- Unrecorded
- Surveyed In
- Referenced Out


**Previous Renewals / Surveys, etc.**

Originally Surveyed by Gates in 1859. He set a post in a mound of earth.

**Monuments and Accessories Found: (Condition and Source)**

None.


**Diagram**

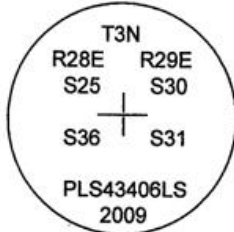

MP 3 Sign

No Trespass Sign

**Sketch**

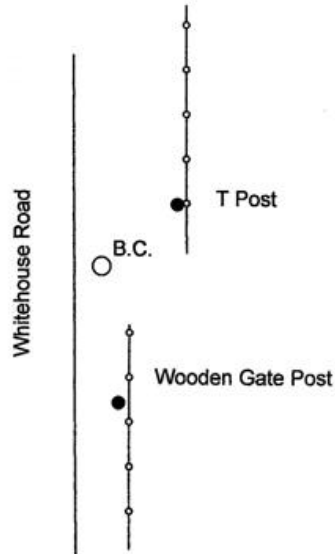

NAD 83/91  
OREGON STATE PLANE NORTH  
INTERNATIONAL FEET

N745231.53  
E8521831.23

LAT - 45° 42' 14.26043" N  
LON - 119° 14' 54.45223" W

**Monument (s) Set (Procedures and Description)**

Set a 1 1/8" x 30" galvanized iron pipe with a 2 1/2" Brass cap at projection of old fenceline and using the monuments to the North and South for line.

**References Set:**

- A 1/8" Iron rebar w/ypc #43406 at steel fence post, lies N 44°00' E, 34.40'.
- A 1/8" Iron rebar w/ypc #43406 at wooden gate post, lies S 9°15' E, 57.80'.
- A 1/8" Iron rebar w/ypc #43406 at a "no trespass" sign, lies S 33°15' W, 141.86'.
- A 1/8" Iron rebar w/ypc #43406 at "Mile Post 3" sign, lies N 15° W, 116.57'.

**Location and Comments**

From the intersection of Hwy. 320 and Whitehouse Road, go 1.5 miles South along Whitehouse Road.

**Compass Declination**

17° E

**Surveyors Seal**

REGISTERED  
PROFESSIONAL  
LAND SURVEYOR

*Robert Douglas English*  
OREGON  
JANUARY II, 2005  
ROBERT DOUGLAS ENGLISH  
43406LS

RECEIVED BY:

**Firm / Agency**

Date: 10-09  
Rec'd By: KK  
No. D9-446-R

Survey One, LLC.  
P.O. Box 382  
Pendleton, OR 97801  
(541) 276-2055

RENEWAL DATE: 12/31/09