

OREGON CORNER RESTORATION FORM

Section 30,31
County Umatilla

Township 3N
Date: 3/5/10

Range 29E

Corner Designation: 3N29V3

1/4 Corner common to sections 30,31 T3NR29E.

- Condition Report Only
- Not Found
- Remonumented
- Unrecorded
- Surveyed In
- Referenced Out


Previous Renewals / Surveys, etc.

Originally Surveyed by Gates in 1859. He set a post in a mound of earth.


Monuments and Accessories Found: (Condition and Source)

Found pyramidally shaped stone, similar to others found near Harris's monuments, at fence corner.

Diagram

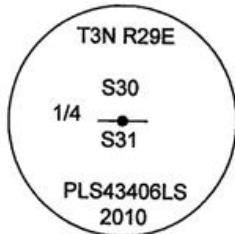

Sketch

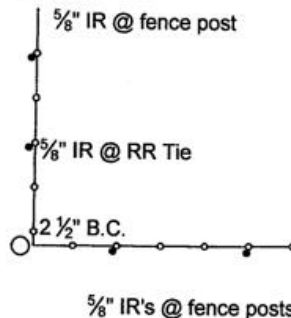

NAD 83/91
OREGON STATE PLANE NORTH
INTERNATIONAL FEET

N745304.52
E8525066.06

LAT - 45° 42' 14.48859" N
LON - 119° 14' 08.86628" W

Monument (s) Set (Procedures and Description)

Set a 1 1/8" x 30" galvanized iron pipe with a 2 1/2" Brass cap, flush with ground, at a found stone and an old fence corner. Buried stone alongside monument. Cap marked as shown above.

References Set:

- A 5/8" Iron rebar w/ypc #43406 at a steel fence post, lies S 89°30' E, 39.85'.
- A 5/8" Iron rebar w/ypc #43406 at a steel fence post, lies S 88°20' E, 22.78'.
- A 5/8" Iron rebar w/ypc #43406 at a RR Tie fence post, lies N 2°15' E, 26.69'.
- A 5/8" Iron rebar w/ypc #43406 at a steel fence post, lies N 2° E, 50.09'.

Location and Comments

From the intersection of Hwy. 320 and Snow Road, go 2.2 miles South, and 1 mile West along the fence.

Compass Declination
17° E

Surveyors Seal

REGISTERED
PROFESSIONAL
LAND SURVEYOR

Robert D. English
OREGON
JANUARY 11, 2005
ROBERT DOUGLAS ENGLISH
43406LS

RECEIVED BY:

Date: 1-11
Rec'd By: RF
No. 11-19-R

Firm / Agency

Survey One, LLC.
P.O. Box 382
Pendleton, OR 97801
(541) 276-2055

RENEWAL DATE: 12/31/11