

**OREGON CORNER RESTORATION FORM**

Section 31  
County Umatilla

Township 3N  
Date: 09/22/09

Range 29E

Corner Designation: 3N29X1

1/4 corner common to sections 31, T3NR29E, and 36, T3NR28E.

_____	Condition Report Only
_____X_____	Not Found
_____X_____	Remonumented
_____	Unrecorded
_____X_____	Surveyed In
_____X_____	Referenced Out


**Previous Renewals / Surveys, etc.**

Originally Surveyed by N.H. Gates in 1859. He set a post in a mound of earth.


**Monuments and Accessories Found: (Condition and Source)**

None.

**Diagram**

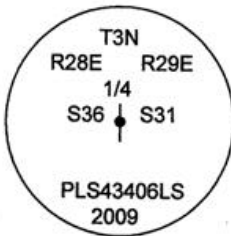

**Sketch**

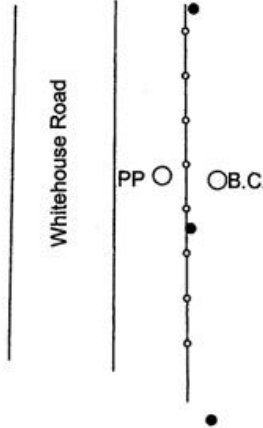

NAD 83/91  
OREGON STATE PLANE NORTH  
INTERNATIONAL FEET

N742538.06  
E8521879.27

LAT - 45° 41' 47.66820" N  
LON - 119° 14' 54.37004" W

**Monument (s) Set (Procedures and Description)**

A 1 1/2" X 30" galvanized Iron pipe with 2 1/2" Brass Cap, by single proportionate methods.

**References Set:**

- A 5/8" x 30" Iron rebar w/ypc #43406 at wooden gate post, lies N 2°00' W, 43.66'.
- A 5/8" x 30" Iron rebar w/ypc #43406 at steel fence post, lies S 35°00' W, 6.84'.
- A 5/8" x 30" Iron rebar w/ypc #43406 at wooden fence post, lies S 7°30' W, 51.24'.
- A pk nail w/ brass washer #43406 on power pole, lies N 89°00' W, 5.91'.

**Location and Comments**

The corner is 2 miles South of the intersection of Hwy. 320 and Whitehouse Road.

**Compass Declination**  
17° E

**Surveyors Seal**

REGISTERED  
PROFESSIONAL  
LAND SURVEYOR

*Robert D. English*  
OREGON  
JANUARY 11, 2005  
ROBERT DOUGLAS ENGLISH  
43406LS

**RECEIVED BY:**

Date: 1-11  
Rec'd By: RK  
No. 11-20-R

**Firm / Agency**

Survey One, LLC.  
P.O. Box 382  
Pendleton, OR 97801  
(541) 276-2055

RENEWAL DATE: 12/31/09