

# CORNER RESTORATION FORM

Township 3N & 4N Range 30E Section 2 & 35 County UMATILLA

State OREGON Date 4-8-2015 Number A-19

Corner Designation : 1/4 SECTION 2 & 35


Condition Report Only  
 Not Found  
 Renewed  
 Surveyed In  
 Referenced

Previous Renewals ORIGINAL SOURCE OF CORNER

UNDER GLO CONTRACT #84 BY N. GATES DATED
JULY 22, 1859 SET POST
Accessories Found:
NONE

### MONUMENT DETAIL

Found  Set

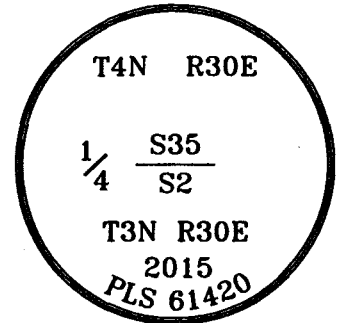

BASIS OF BEARINGS, NAD 83/91 OREGON STATE PLANE COORDINATES NORTH ZONE:

NORTHING: 772995.407  
 EASTING: 8577936.797

#### Monument & Accessories Set (Procedure and Description)

- SET 2 1/2" BRASS CAP ON 1 1/4"x30" PIPE IN FIELD 1.5 BELOW GRADE, WITH MARKER SIGN ON GREEN STEEL POST.
- SET 5/8" REBAR & CAP PLS 61420 0.7' BELOW GRADE N28°06'E 10.49'.
- SET 5/8" REBAR & CAP PLS 61420 0.7' BELOW GRADE S57°59'E 17.26'.
- SET 5/8" REBAR & CAP PLS 61420 0.7' BELOW GRADE, S0°45'E 24.31'.
- SET 5/8" REBAR & CAP PLS 61420 AT GRADE SOUTH SIDE OF RAILROAD TIE POST BEARING OBJECT SIGN ON RAILROAD TIE POST, N79°51'W 237.30'.

<p style="text-align: center;"><u>Sketch of Monument, Accessories and General Area</u></p> <p>             SET 5/8" REBAR &amp; CAP PLS 61420 AT GRADE SOUTH SIDE OF RAILROAD TIE POST, BEARING OBJECT SIGN ON RAILROAD TIE POST              SET 5/8" REBAR &amp; CAP PLS 61420 0.7' BELOW GRADE              SET 2 1/2" BRASS CAP ON 1 1/4"x30" PIPE 1.5' BELOW GRADE IN FIELD, MARKER SIGN ON GREEN STEEL POST         </p>	<div style="border: 1px solid black; padding: 5px; text-align: center;"> <b>REGISTERED PROFESSIONAL LAND SURVEYOR</b> </div> <div style="border: 1px solid black; padding: 5px; text-align: center;"> <b>OREGON</b>                  MAY 10, 2011  <b>LANCE CLARK KING</b>                  61420             </div> <div style="border: 1px solid black; padding: 5px; text-align: center;"> <b>RENEWS: 6/30/2015</b> </div> <div style="border: 1px solid black; padding: 5px;"> <b>Agency:</b>                  CK3, LLC                  945 W. ORCHARD                  HERMISTON OREGON 97838                  OFFICE: 541-567-2345                  FAX: 541-567-2305                  WEB: CK3LLC.NET                  Field Book # 0-289             </div> <div style="border: 1px solid black; padding: 5px;"> <b>COUNTY SURVEYOR RECORDING INFO</b>                  Received <u>Jay Roberts</u>                  Filed <u>6/12/2015</u>                  Survey No. <u>15-050-C</u>                  Drawing No. <u>C-853</u>                  Index No. <u>A-19</u> </div>
---	--