

CORNER RESTORATION FORM

Township 3N Range 29E & 30E Section 7 & 12 County UMATILLA

State OREGON Date 9-15-2014 Number G-1

- Condition Report Only
- Not Found
- Renewed
- Surveyed In
- Referenced

Corner Designation : 1/4 SECTION 7 & 12

Previous Renewals ORIGINAL SOURCE OF CORNER

UNDER GLO CONTRACT #84 BY N. GATES DATED
JULY 22, 1859 SET POST

Accessories Found:


NONE

BASIS OF BEARINGS, NAD 83/91 OREGON STATE PLANE
 COORDINATES NORTH ZONE:

NORTHING: 764536.290
 EASTING: 8553810.046

MONUMENT DETAIL

Found Set

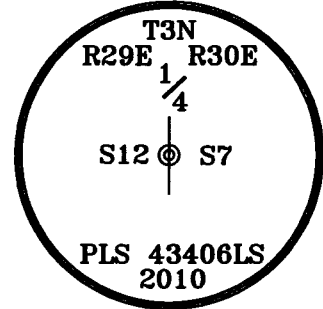

Monument & Accessories Set (Procedure and Description)

FOUND BRASS 2 1/2" CAP APPROXIMATELY 18" BELOW FIELD GRADE. PER SURVEY No. 11-038-C.

Sketch of Monument, Accessories and General Area

FIELD



FOUND BRASS 2 1/2"
 CAP APPROXIMATELY 18"
 BELOW FIELD GRADE.

FIELD

**REGISTERED
 PROFESSIONAL
 LAND SURVEYOR**

Lance Clark King
**OREGON
 MAY 10, 2011
 LANCE CLARK KING
 61420**

RENEWS: 6/30/2017

Agency:

**CK3, LLC
 945 W. ORCHARD
 HERMISTON OREGON 97838
 OFFICE: 541-567-2345
 FAX: 541-567-2305
 WEB: CK3LLC.NET
 Field Book # 0-298**

**COUNTY SURVEYOR
 RECORDING INFO**

Received *Jay Whit*
 Filed 6/12/2015
 Survey No. 15-050-C
 Drawing No. C-853
 Index No. G-1