

CORNER RESTORATION FORM

Township 3N Range 30E Section 16 & 15 County UMATILLA

State OREGON Date 10-6-2014 Number L-13

- Condition Report Only
- Not Found
- Renewed
- Surveyed In
- Referenced

Corner Designation : 1/4 SECTION 16 & 15

Previous Renewals ORIGINAL SOURCE OF CORNER

UNDER GLO CONTRACT #84 BY N. GATES DATED
JULY 22, 1859 SET POST

Accessories Found:


NONE.

BASIS OF BEARINGS, NAD 83/91 OREGON STATE PLANE
 COORDINATES NORTH ZONE:

NORTHING: 759466.589
 EASTING: 8570330.685

MONUMENT DETAIL

Found Set

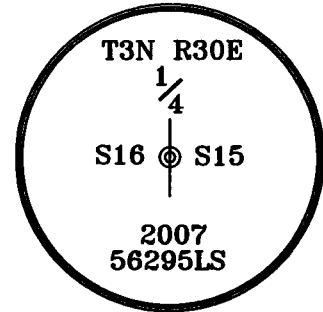

Monument & Accessories Set (Procedure and Description)

FOUND 2 1/4" BRASS CAP 6" BELOW ROAD GRADE. PER SURVEY No. 07-243-R.

Sketch of Monument, Accessories and General Area

