

CORNER RESTORATION FORM

Township 3N Range 30E & 31E Section 13 & 18 County UMATILLA

State OREGON Date 3-10-2015 Number L-25

Corner Designation : 1/4 CORNER SECTION 13 & 18

Previous Renewals ORIGINAL SOURCE OF CORNER

UNDER GLO CONTRACT #81 BY D. THOMPSON DATED
 JULY 8, 1859 SET POST

Accessories Found:

NONE


BASIS OF BEARINGS, NAD 83/91 OREGON STATE PLANE
 COORDINATES NORTH ZONE:

NORTHING: 759903.705
 EASTING: 8586151.391

Condition Report Only
 Not Found
 Renewed
 Surveyed In
 Referenced

MONUMENT DETAIL

Found Set

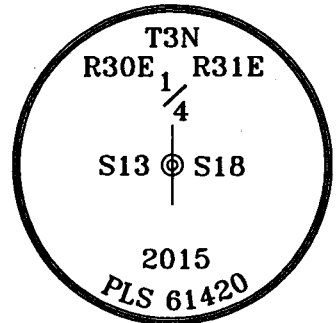

Monument & Accessories Set (Procedure and Description)

- SET 2 1/2" BRASS CAP ON 1 1/2" PIPE 0.5' BELOW BOTTOM OF BORROW DITCH.
- SET 5/8" REBAR & CAP PLS 61420 AT GRADE N71°31'E 28.59'.
- SET PK & WASHER PLS 61420 IN POWER POLE S1°11'W 36.97', SOUTH OF PEEBLER ROAD.
- SET 5/8" REBAR & CAP PLS 61420 AT GRADE ON BANK S56°32'W 46.50', WITH BEARING OBJECT SIGN ON GREEN STEEL POST.
- SET PK & WASHER PLS 61420 IN GUY WIRE POLE N0°27'W 11.88', WITH BEARING OBJECT SIGN ON THE GUY WIRE POLE.

Sketch of Monument, Accessories and General Area

The sketch shows a central point with several lines extending to other markers. A vertical line goes up to a 'GUY WIRE POLE' (N0°27'W 11.88') and down to a 'POWER POLE' (S1°11'W 36.97'). A line goes east to a 'REBAR & CAP' (N71°31'E 28.59'). A line goes southwest to a 'REBAR & CAP ON BANK' (S56°32'W 46.50'). A line goes northwest to a 'BRASS CAP ON PIPE' (S1°11'W 36.97'). The area is labeled 'GRASSY PASTURE' and 'PEEBLER ROAD (GRAVEL)'. Other labels include 'FIELD', 'OHP', and 'GREEN STEEL POST ON ROAD BANK'.

**REGISTERED
PROFESSIONAL
LAND SURVEYOR**

Lance Clark King

**OREGON
MAY 10, 2011
LANCE CLARK KING
61420**

RENEWS: 6/30/2015

Agency:
 CK3, LLC
 945 W. ORCHARD
 HERMISTON OREGON 97838
 OFFICE: 541-567-2345
 FAX: 541-567-2305
 WEB: CK3LLC.NET
 Field Book # 0-289

**COUNTY SURVEYOR
RECORDING INFO**

Received *May 10, 2015*

Filed *6/12/2015*

Survey No. *15-050-C*

Drawing No. *C-853*

Index No. L-25