

# CORNER RESTORATION FORM

Township 3N Range 30E Section 15,14,22&23 County UMATILLA

State OREGON Date 4-22-2015 Number N-17

Corner Designation : SECTION 15, 14, 22 & 23

Condition Report Only  
 Not Found  
 Renewed  
 Surveyed In  
 Referenced

Previous Renewals ORIGINAL SOURCE OF CORNER

UNDER GLO CONTRACT #95 BY W. CAMPBELL DATED  
SEPTEMBER 19, 1860 SET POST  
CALCULATED BY SURVEY PARTITION PLAT 2007-46.

Accessories Found:


NONE

BASIS OF BEARINGS, NAD 83/91 OREGON STATE PLANE COORDINATES NORTH ZONE:

NORTHING: 756921.528  
 EASTING: 8575633.308

## MONUMENT DETAIL

Found  Set

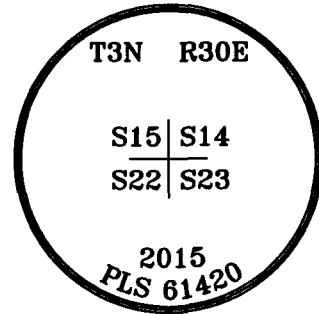

### Monument & Accessories Set (Procedure and Description)

- SET 2 1/2" BRASS CAP ON 1 1/4"x30" PIPE 0.5' ABOVE GRADE, SET SURVEY MAKER SIGN ON GREEN STEEL POST.
- SET 5/8" REBAR & CAP PLS 61420 AT GRADE, N27°16'E 28.26'.
- SET 5/8" REBAR & CAP PLS 61420 AT GRADE NEXT TO EXISTING RUSTY STEEL POST, S10°17'E 30.84', SET BEARING OBJECT SIGN ON THE EXISTING RUSTY STEEL POST.
- SET 5/8" REBAR & CAP PLS 61420 AT GRADE, S54°53'W 20.83'.
- SET 5/8" REBAR & CAP PLS 61420 AT GRADE, N58°48'W 33.22'.

**Sketch of Monument, Accessories and General Area**

**REGISTERED PROFESSIONAL LAND SURVEYOR**

*Lance Clark King*

**OREGON  
MAY 10, 2011  
LANCE CLARK KING  
61420**

**RENEWS: 6/30/2017**

**Agency:**  
CK3, LLC  
945 W. ORCHARD  
HERMISTON OREGON 97838  
OFFICE: 541-567-2345  
FAX: 541-567-2305  
WEB: CK3LLC.NET  
Field Book # 0-298

**COUNTY SURVEYOR  
RECORDING INFO**

Received *Jay Robert*

Filed 6/12/2015

Survey No. 15-050-C

Drawing No. C-853

Index No. N-17