

**OREGON CORNER RESTORATION FORM**

COUNTY: Umatilla DATE: 09/17/13

CORNER DESIGNATION: 3N32, E03, The North One-Quarter Corner of Section 7.

PREVIOUS RENEWALS/SURVEYS ETC.: Corner originally established by David Chaplin, under Contract 107, dated September 1864, notes state: Set post for 1/4 Sec. cor. in mound of Earth with charred stake pits & c as per instructions.

MONUMENT AND ACCESSORIES FOUND: None.

MONUMENT MARKING DETAIL:

T3N R32E  
1 S6  
4 S7  
2013  
PLS 54657

MONUMENT SET: Held a point 1 foot West of cut off power pole field line marker with field lines running North and East as best remaining evidence of the original corner position. At reestablished corner point, set a 2 3/8" brass cap on a 1 1/4" x 30" galvanized iron pipe with top 14" below ground level, marked as shown in "Monument Marking Detail", from which:  
A silver deep-1 magnet, buried 20" in the ground, bears North 50° East, 37.6 feet.  
A pink deep-1 magnet, buried 20" in the ground, bears South 40° East, 36.2 feet.  
A blue deep-1 magnet, buried 20" in the ground, bears South 48 1/2° West, 37.4 feet.  
An orange deep-1 magnet, buried 20" in the ground, North 46 1/2° West, 34.7 feet.  
Buried bearing object tags with magnets and attached witness post sign to cut off power pole 12 feet East of monument.

LOCATION AND COMMENTS: There are field lines running North and East from corner.

OREGON STATE PLANE COORDINATE, North Zone, NAD 83(91), International Feet:


N= 767970.82'  
E= 8620786.39'

FIRM: Wells Surveying  
P.O. Box 1696  
Pendleton, OR 97801

COMPASS DECLINATION: 18° East Surveyor's Seal

Witnesses: Jason Wells, PLS  
Dean Roy

\3N32E03

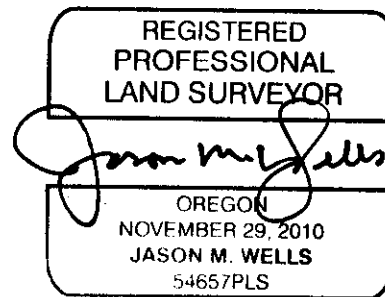

RENEWS: 6-30-14