

# OREGON CORNER RESTORATION FORM

COUNTY: Umatilla DATE: 8/22/13

CORNER DESIGNATION: 3N32, G05, The West One-Quarter Corner of Section 8.

PREVIOUS RENEWALS/SURVEYS ETC.: Corner originally established by David Chaplin, under Contract 107, dated September 1864, notes state: Set post for 1/4 Sec. cor. in mound of Earth with charred stake pits & c as per instructions.

MONUMENT AND ACCESSORIES FOUND: None.

## MONUMENT MARKING DETAIL:

T3N R32E  
1/4  
S7 | S8  
2013  
PLS 54657

MONUMENT SET: Reestablished corner at the intersection of field berms North, South and East as best available evidence of the original corner position and set a 2 3/8" brass cap on a 1 1/4" x 30" galvanized iron pipe with top flush with ground 1 foot North of 3" steel field marker pipe, marked as shown in "Monument Marking Detail", from which:

A silver deep-1 magnet, 20" in ground bears North 41° East, 28.8 feet.

A pink deep-1 magnet, 20" in ground bears South 45° East, 33.9 feet.

A blue deep-1 magnet, 20" in ground bears South 41° West, 34.6 feet.

An orange deep-1 magnet, 20" in ground bears North 45° West, 36.7 feet.

Buried bearing object tags with magnets. Attached witness post sign to 3" post by monument.

LOCATION AND COMMENTS: Corner at a point with field berms North, South, and East, 1 foot North of a 3" steel field marker pipe.

OREGON STATE PLANE COORDINATE, North Zone, NAD 83(91), International Feet:

N= 765335.99'

E= 8623499.89'


FIRM: Wells Surveying  
P.O. Box 1696  
Pendleton, OR 97801

COMPASS DECLINATION: 18° East

Surveyor's Seal

Witnesses: Jason Wells, PLS  
Dean Roy

\3N32G05

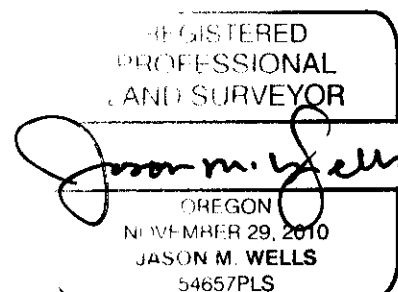

RENEWS: 6-30-14