

OREGON CORNER RESTORATION FORM

COUNTY: Umatilla DATE: 05/30/13

CORNER DESIGNATION: 3N32, P21, The East One-Quarter Corner of Section 23.

PREVIOUS RENEWALS/SURVEYS ETC.: Corner originally established by David Chaplin, under GLO Contract dated September 1864, notes state: Set post for 1/4 Sec. cor. in mound of earth with charred stake pits & as per instructions.

MONUMENT AND ACCESSORIES FOUND: None.

MONUMENT MARKING DETAIL:

T3N R32E
1/4
S23|S24
2013
PLS 54657

MONUMENT SET: Reestablished corner position by single proportion measure between the Southeast and Northeast corners of Section 23. The corner point falls in the centerline of Campbell Road. At the reestablished corner point, set a 2 3/8" brass cap on a 1 1/4" x 30" galvanized iron pipe, with top 12" below gravel road surface, stamped as stated in "Monument Marking Detail", from which:

A silver deep-1 magnet buried 20" below ground in road bears North 51° East, 25.2 feet.

A 3/4" brass washer stamped "PLS1106" in railroad tie marker post bears South 19° East, 66.9 feet.

A 5/8" x 24" rebar with a 1 1/4" purple plastic cap stamped "Wells Surveying, PLS 54657", in road bank bears South 27° West, 35.7 feet.

An orange deep-1 magnet buried 20" in ground in road bank bears North 34° West, 29.1 feet. Bearing object signs with accessories.

LOCATION AND COMMENTS: Located in the centerline of Campbell Road.

OREGON STATE PLANE COORDINATE, North Zone, NAD 83(91), International Feet:

N= 755238.58'


E= 8644844.81'

FIRM: Wells Surveying
P.O. Box 1696
Pendleton, OR 97801

COMPASS DECLINATION: 18° East Surveyor's Seal

Witnesses: Jason Wells, PLS
Dean Roy

/3N32P21

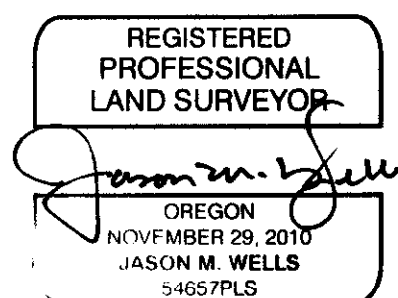

RENEWS: 6-30-14