

OREGON CORNER RESTORATION FORM

COUNTY: Umatilla DATE: 07/16/13

CORNER DESIGNATION: 3N32, R13, The Northwest Corner of Section 27.

PREVIOUS RENEWALS/SURVEYS ETC.: Corner originally established by David Chaplin, under GLO Contract dated September 1864, notes state: Set post for corner to Secs. 21, 22, 27 & 28 in mound of Earth with charred stake, pits, & as per instructions. Corner located by David Krumbein, Survey 89-76-A, record states: "Set concrete nail at centerline of Highway 37 and fence line to East". Corner position computed by David Haddock, Survey 97-172-B, record states: "Monument from Survey 89-76-A, not found". Corner computed by Stephen Haddock, on Survey 06-606-C, record states: Corner point calculated using data from survey of record. No monument found or set."

MONUMENT AND ACCESSORIES FOUND: None.

MONUMENT MARKING DETAIL: Set railroad spike, marked as indicated below.

MONUMENT SET: Held the calculated corner point from Stephen Haddock's position from ties to his Survey No. 06-606-C. At centerline of Highway 37 set a railroad spike stamped "PLS 54657+" 1" below asphalt surface. From which:

A 3/4" brass washer stamped "PLS 1106", in a PP&L pole #220561, bears North 09° East, 174.0 feet.

A 3/4" brass washer stamped "PLS 1106", in a PP&L pole #270960, bears South 21° East, 79.4 feet.

A 5/8" x 24" iron rod with a 1 1/4" purple plastic cap stamped "Wells Surveying, PLS 54657" bears South 53° West, 30.9 feet.

A 5/8" x 24" iron rod with a 1 1/4" purple plastic cap stamped "Wells Surveying, PLS 54657" bears North 27 1/2° West, 34.9 feet

Attached bearing object tags to poles and rebar.

LOCATION AND COMMENTS: Located in the centerline of Highway 37 with field lines East and West.

OREGON STATE PLANE COORDINATE, North Zone, NAD 83(91), International Feet:

N= 752391.87'


E= 8634322.55'

FIRM: Wells Surveying
P.O. Box 1696
Pendleton, OR 97801

COMPASS DECLINATION: 18° East

Surveyor's Seal

Witnesses: Jason Wells, PLS
Dean Roy
3N32R13

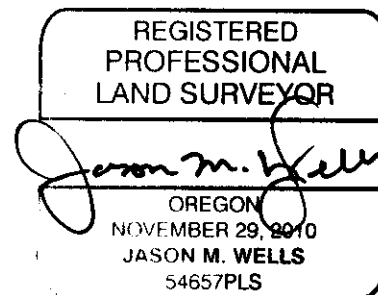

RENEWS: 6-30-14