

OREGON CORNER RESTORATION FORM

COUNTY: Umatilla

DATE: 08-27-2012

CORNER DESIGNATION:

R-5, The Southwest Corner of Section 20, Township 3 North, Range 32 East, Willamette Meridian, Umatilla County, Oregon.

PREVIOUS RENEWALS / SURVEYS, ETC.:

The corner was originally established by U.S. Deputy Surveyor, Daniel Chaplin, under contract No. 107 in 1864, who set a post for Sections 19, 20, 29 & 30 in a mound of Earth with charred stake, pits &c.

The survey for the establishment of Hagen Road (Road 179) in 1884 states "run North on line between Sections 19 & 20". No monument is mentioned or shown in the field survey notes for the corner in question.


An undated, hand prepared sketch found in the records of the Umatilla County Surveyors Office shows the hand written note "(charred stake), 14" x 12" x 6" stone, marked X, bottle under". It appears that this sketch is from the old Hayes and Harris files.

An undated survey for George La Fontaine & Charles Hester prepared by Frank Hayes, Umatilla County Surveyor notes "Relocated Corner, Set 8" x 10" x 12" Stone, 18" deep. Marked X".

MONUMENT AND ACCESSORIES FOUND:

Accepted the apparent center line of Hagen Road as the best remaining evidence of the West line of Section 20, no other corner evidence found. See the 2012 J-U-B Engineers, Inc. Partition Plat for Tim Weidert for complete survey and corner details.

MONUMENT MARKING DETAIL:

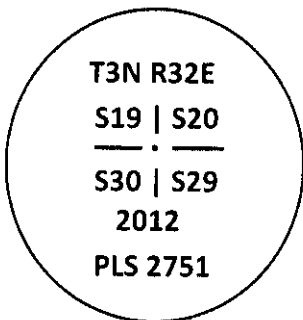

MONUMENT SET:

Set 2-1/4" x 12" Aluminum pipe with a 3-1/4" Aluminum Cap with Deep-1 magnet in concrete, buried 6" below gravel road surface. The monument is approximately 1.2' East of the apparent center line of Hagen Road (12' gravel surface) and approximately 46' South of an existing drainage ditch bridge. The Aluminum Cap is marked as shown above in the Monument Marking Detail.

RECEIVED BY

Umatilla County Surveyor

Date: 9/10/12

Rec'd By: J. Rex

No.: 12-123-R

NEW ACCESSORIES:

Set mag nail with red plastic washer stamped "JUB Control" in power pole, 1.0' above ground in North face of said power pole with bearing tag which bears S90°E, 13.10' from Aluminum Cap.

Set mag nail with red plastic washer stamped "JUB Control" in top of Southwest bridge abutment which bears N24°W, 44.94' from Aluminum Cap.

Set mag nail with red plastic washer stamped "JUB Control" in power pole, 1.0' above ground in West face of said power pole with bearing tag which bears N04°E, 147.86' from Aluminum Cap.

LOCATION AND COMMENTS:

The corner is located in Hagen Road.

REFERENCE OBJECT MEASUREMENT PROCEDURE:

Reference bearings were obtained with a Silva Ranger Compass with a declination of 15° East. Reference distances were measured using a 100-foot steel tape.

FIRM / AGENCY:

J-U-B Engineers, Inc.
2810 W. Clearwater Avenue, Suite 201
Kennewick, WA 99336
509-783-2144

WITNESSES:

Steven Day, Party Chief
Felipe Hernandez, Instrument Man

SURVEYOR'S SEAL

08-27-2012

REGISTERED
PROFESSIONAL
LAND SURVEYOR

[Handwritten Signature]
OREGON
JAN 13, 1996
JOHN JOSEPH SHEA
2751LS

RENEWAL DATE: 6-30-14

RECEIVED BY

Umatilla County Survey
Date: 9/10/12
Rec'd By: J. Oles
No.: 12-123-R