

OREGON CORNER RESTORATION FORM

Section 30 Township 3N
County Umatilla Date: 03/11/11

Range 33E

Corner Designation: 3N33T1

1/4 corner common to sections 30, T3NR33E, 25,
T3NR32E.

_____	Condition Report Only
X _____	Not Found
X _____	Remonumented
_____	Unrecorded
X _____	Surveyed In
X _____	Referenced Out


Previous Renewals / Surveys, etc.

Originally Surveyed by Thompson in 1864. He set a post in a mound of earth.

Monuments and Accessories Found: (Condition and Source)

None.


Diagram

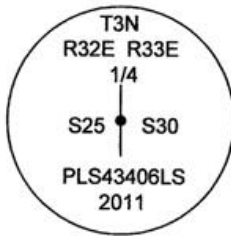

NAD 83/91
OREGON STATE PLANE NORTH
INTERNATIONAL FEET

N750092.44
E8650268.20

Sketch

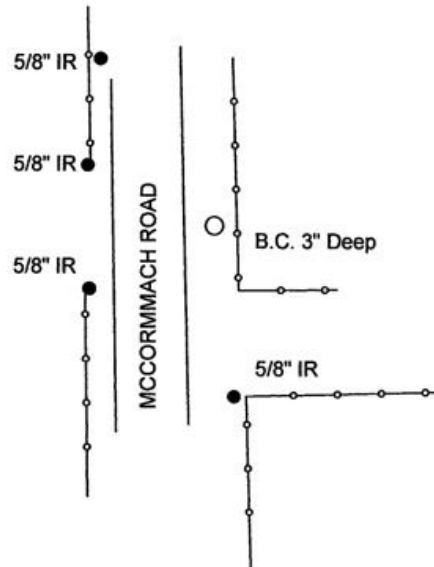

Monument (s) Set (Procedures and Description)

Set a 1 1/8" x 30" galvanized iron pipe with a 2 1/2" brass cap, 3 inches below the surface by single proportionate measure. Corner falls East of McCormmach Road.

References Set:

- A 5/8" Iron rebar w/ypc #43406 lies S 6°50' E, 51.92'.
- A 5/8" Iron rebar w/ypc #43406 lies S 46°10' W, 42.38'.
- A 5/8" Iron rebar w/ypc #43406 lies N 40°20' W, 47.95'.
- A 5/8" Iron rebar w/ypc #43406 lies N 20° W, 93.17'.

Location and Comments

From the intersection of Fulton Rd.
and McCormmach Rd, go 1.5 miles
South to the point.

Compass Declination

17° E

Surveyors Seal

REGISTERED
PROFESSIONAL
LAND SURVEYOR

Robert D. English
OREGON
JANUARY 11, 2005
ROBERT DOUGLAS ENGLISH
43406LS

RECEIVED BY:

Date: _____
Rec'd By: _____
No. _____

Firm / Agency

Survey One, LLC.
P.O. Box 382
Pendleton, OR 97801
(541) 276-2055

RENEWAL DATE: 12/31/11