

**OREGON CORNER RESTORATION FORM**

Section: 25, 30 Township: 3N Range: 32E, 33E  
 County: Umatilla Date: 3/9/2011

Corner Designation: 3N33T01 (Amended 3/12/2012)

Quarter corner common to Sections 25, T3NR32E; 30, T3NR33E.

	Condition Report Only
X	Not Found
X	Remonumented
	Unrecorded
X	Surveyed In
X	Referenced Out


**Previous Renewals / Surveys, etc.**

Originally surveyed by Thompson in 1864. He set a post in a mound of earth.

**Monuments and Accessories Found: (Condition and Source):**

None.


Diagram

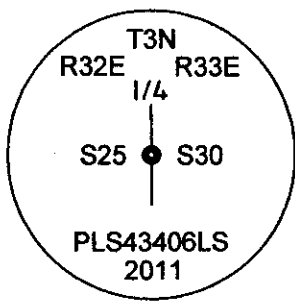

NAD 83/91  
 OREGON STATE PLANE NORTH  
 INTERNATIONAL FEET

N750092.51  
 E8650268.20

Sketch

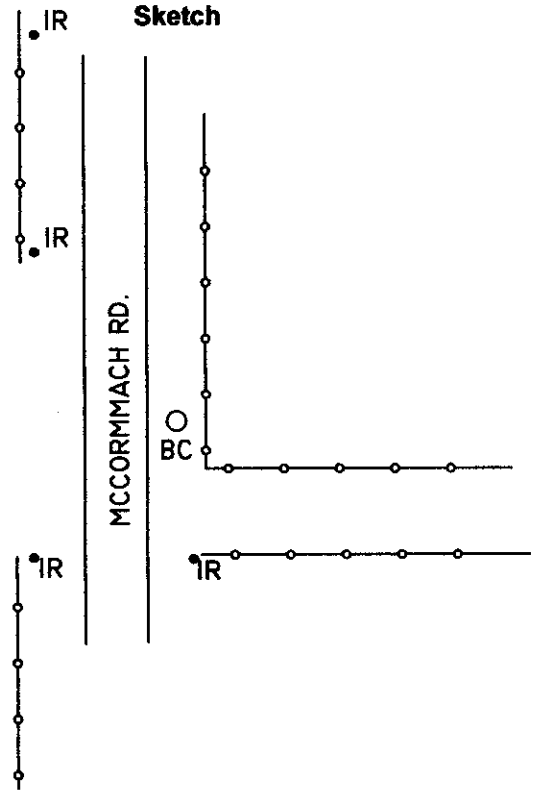

**Monument(s) Set (Procedures and Description):**

Set a 1 1/8" x 30" galvanized iron pipe with a 2 1/2" brass cap, stamped as shown above, 3" below the surface, using single proportionate method.

**References Set:**

- A 5/8" iron rebar w/YPC #43406 lies N 40° 20' W, 47.95'.
- A 5/8" iron rebar w/YPC #43406 lies N 20° W, 93.17'.
- A 5/8" iron rebar w/YPC #43406 lies S 6° 50' E, 51.92'.
- A 5/8" iron rebar w/YPC #43406 lies S 46° 10' W, 42.38

**Location and Comments:**

The corner is 1 1/2 miles South of the intersection of Fulton Rd. and McCormmach Rd.

**Compass Declination**

17° E

**Surveyors Seal**

REGISTERED  
 PROFESSIONAL  
 LAND SURVEYOR

*Robert D. English*  
 OREGON  
 JANUARY 11, 2005  
 ROBERT DOUGLAS ENGLISH  
 43406LS

RENEWAL DATE: 12/31/13

**RECEIVED BY:**

Date: 7/10/2012  
 Rec'd By: [Signature]  
 No. 12-094-C

**Firm / Agency**

Survey One, LLC.  
 P.O. Box 382  
 Pendleton, OR 97801  
 (541) 276-2055