

OREGON CORNER RESTORATION FORM

COUNTY: Umatilla DATE: 04/11/13

CORNER DESIGNATION: 3N32, V23, The South One-Quarter Corner of Section 25.

PREVIOUS RENEWALS/SURVEYS ETC.: Corner originally established by David Chaplin, under GLO Contract dated September 1864, notes state: Set stone for 1/4 Sec. Cor.

MONUMENT AND ACCESSORIES FOUND: None. There were a few scattered stones at the corner point but the record stone was not found.

MONUMENT MARKING DETAIL:

T3N R32E
1 S25
4 S36
2013
PLS 54657

MONUMENT SET: Held a point 0.5 feet South of steel fence post field corner marking post (post is 0.5' West of new wood fence brace post) as best remaining evidence of the original corner point. There are field lines extending West and South from the corner point. At the reestablished corner position, set a 2 3/8" brass cap on a 1 1/4" x 30" galvanized iron pipe, with top flush with the ground, surrounded by a few stones, stamped as stated in "Monument Marking Detail", from which:

A 5/8" x 24" rebar with a 1 1/4" purple plastic cap stamped "Wells Surveying, PLS 54657", bears North 88° East, 18.6 feet.

A 5/8" x 24" rebar with a 1 1/4" purple plastic cap stamped "Wells Surveying, PLS 54657", North 88° East, 42.2 feet.

A 5/8" x 24" rebar with a 1 1/4" purple plastic cap stamped "Wells Surveying, PLS 54657", bears North 87° West, 20.1 feet.

A 5/8" x 24" rebar with a 1 1/4" purple plastic cap stamped "Wells Surveying, PLS 54657", bears North 88° West, 43.0 feet.

All accessories are in a in fence line, wired bearing object tags to rebars. Attached witness post sign to newer round brace post.

LOCATION AND COMMENTS:

Newer fence runs East and West, area around steel fence post is littered with junk and a few stones indicating at one time this was a fence corner area.


OREGON STATE PLANE COORDINATE, North Zone, NAD 83(91), International Feet:

N= 747385.18"
E= 8647665.74'

FIRM: Wells Surveying
P.O. Box 1696
Pendleton, OR 97801

COMPASS DECLINATION: 18° East
Witnesses: Jason Wells, PLS
/3N32V23

Surveyor's Seal

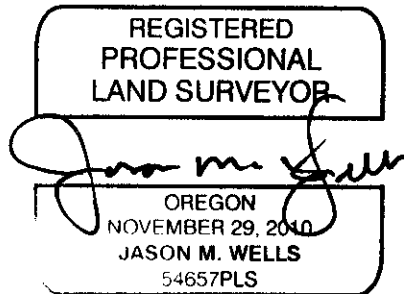

RENEWS: 6-30-14