

**OREGON CORNER RESTORATION FORM**

Section: 1, 6, 36  
County: Umatilla

Township: 2N, 3N  
Date: 2/11/2011

Range: 32E, 33E

Corner Designation: 3N33Z01

Township corner common to Sections 1, T2NR32E; 6, T2NR33E; 36, T3NR32E.

- Condition Report Only
- Not Found
- Remonumented
- Unrecorded
- Surveyed In
- Referenced Out


**Previous Renewals / Surveys, etc.**

Originally surveyed by Thompson in 1864. He set a post in a mound of earth.  
 Surveyed by Moody in 1871. He set a post in a mound of earth.  
 The N. P. Ry. "Wallula to Pendleton" Right of Way Plat, Umatilla County Railroad Map #129, shows the corner at 1,961.3' West of the track centerline. Map #154 shows the corner at 1,961.3' West of the track centerline and 830.3' North of the track centerline.  
 Krumbein set an unrecorded brass cap.  
 In 1988 Wells accepted found brass cap in Survey 88-19-C.  
 In 2001 D. Haddock found 2 1/4" brass cap in Survey 01-81-C.  
 In 2002 Tomkins found 2 1/2" brass cap in Survey 03-25-G.


**Monuments and Accessories Found: (Condition and Source):**

A 2 1/2" brass cap in good condition.  
 A 5/8" iron rebar 1106LS lies N 33° 45' E, 12.38'.  
 A 5/8" iron rebar w/YPC 2360LS lies S 76° 45' W, 27.36'.  
 A 5/8" iron rebar w/YPC 2360LS lies S 25° 45' E, 17.22'.  
 A 5/8" iron rebar w/YPC 2360LS lies N 30° 15' W, 39.40'.  
 Unable to match distances and bearings to accessories found by Tomkins in Z1-03-25G.

Diagram

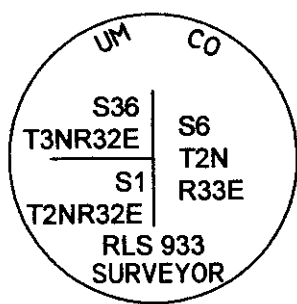

Sketch

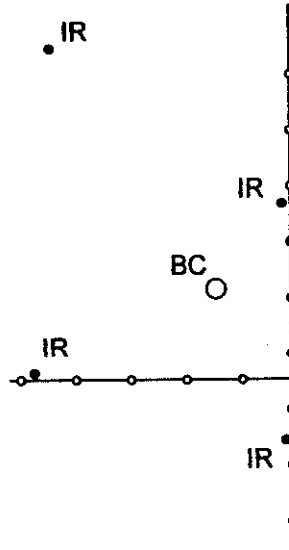

NAD 83/91  
 OREGON STATE PLANE NORTH  
 INTERNATIONAL FEET

N742158.85  
 E8650439.55

**Monument(s) Set (Procedures and Description):**

None.

**References Set:**

None.

**Location and Comments:**

The corner is located 2 1/2 miles South of the intersection of McCormach Rd. and Fulton Rd.

**Compass Declination**

17° E

**Surveyors Seal**

REGISTERED  
 PROFESSIONAL  
 LAND SURVEYOR

*Robert D. English*  
 OREGON  
 JANUARY 11, 2005  
 ROBERT DOUGLAS ENGLISH  
 43406LS

RENEWAL DATE: 12/31/13

**RECEIVED BY:**

Date: 2/10/2012  
 Rec'd By: S. Oles  
 No. 12-094-C

**Firm / Agency**

Survey One, LLC.  
 P.O. Box 382  
 Pendleton, OR 97801  
 (541) 276-2055