

OREGON CORNER RESTORATION FORM

Section 3 Township 3N Range 33E

County Umatilla Date 11-8-85

2-13

CORNER DESIGNATION

- Condition Report Only
- Not Found
- Renewed
- Unrecorded
- Surveyed In
- Referenced Out


Previous Renewals/Surveys, etc. _____

Krumbein Engineering Co. 1976, County No. M-2-C; Krumbein 1981, County No. S-153-B

Monument(s) & Accessories Found: (Condition and Source)

Found railroad spike as per County No. S-153-B at the "T" intersection of a county road and a South running plow line

Monument Detail

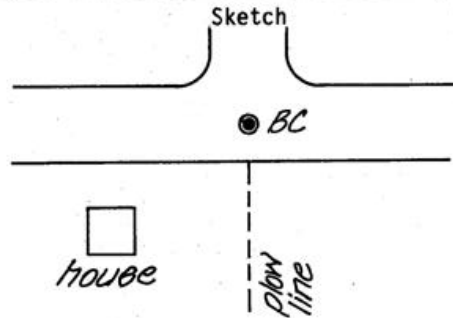

Monument Set (Procedures and Description)

2 1/2" Brass cap on 1 1/2" galvanized pipe set at position of railroad spike and buried 8" below surface

New Accessories

Location & Comments

Surveyor's Seal

Compass Declination _____

Firm/Agency Krumbein Engineering Ltd.

Address 361 S.E. Second Pendleton, Oregon 97801

Party Chief R. Punches

Notes _____

Witness S. Carlson

REGISTERED PROFESSIONAL LAND SURVEYOR

David H. Krumbein
OREGON
JULY 17, 1970
DAVID H. KRUMBEIN
933

RECEIVED BY

Umatilla County Surveyor

Date 6-25-86

Rec'd By [Signature]

No. 86-74 R