

**OREGON CORNER RESTORATION FORM**

Section 2 Township 3N Range 33E  
County Umatilla Date: 03/25/11

Corner Designation: 3N33A19

1/4 corner common to sections 35, T4NR33E, 2, T3NR33E.

- Condition Report Only
- Not Found
- Remonumented
- Unrecorded
- Surveyed In
- Referenced Out


**Previous Renewals / Surveys, etc.**

Originally Surveyed by Thompson in 1864. He set a post in a mound of earth. Krumbein set a 2 1/2" brass cap in 1976, in survey M-121-C.


**Monuments and Accessories Found: (Condition and Source)**

A 2 1/2" B.C. 4" below oil mat surfaced road. (Helix Hwy)  
A 5/8" iron rebar, lying N 43°40' E, 41.73'.

Diagram

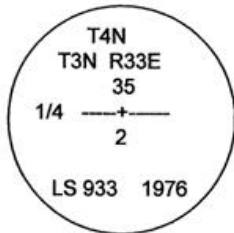

Sketch

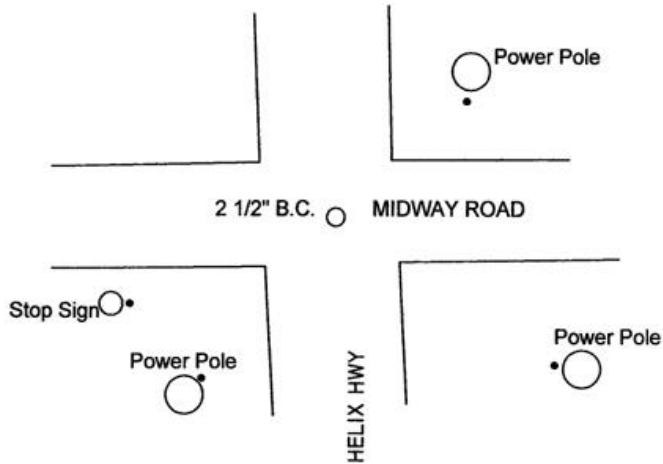

NAD 83/91  
OREGON STATE PLANE NORTH  
INTERNATIONAL FEET

N774365.67  
E8673296.45

**Monument (s) Set (Procedures and Description)**

None.

**References Set:**

- A 5/8" x 30" iron rebar w/rpc #43406, lies S 78° E, 90.66', at a power pole.
- A 5/8" x 30" iron rebar w/rpc #43406, lies S 20°20' W, 64.06', at a power pole.
- A 5/8" x 30" iron rebar w/rpc #43406, lies S 71°30' W, 60.70', at a stop sign.

**Location and Comments**

The corner is in the intersection of Helix Hwy. and Midway Road.

**Compass Declination**

17° E

**Surveyors Seal**

REGISTERED  
PROFESSIONAL  
LAND SURVEYOR

*Robert Douglas English*  
OREGON  
JANUARY 11, 2005  
ROBERT DOUGLAS ENGLISH  
43406LS

**RECEIVED BY:**

Date: \_\_\_\_\_  
Rec'd By: \_\_\_\_\_  
No. \_\_\_\_\_

**Firm / Agency**

Survey One, LLC.  
P.O. Box 382  
Pendleton, OR 97801  
(541) 276-2055

RENEWAL DATE: 12/31/11