

**OREGON CORNER RESTORATION FORM**

Section: 6, 31  
County: Umatilla

Township: 3N, 4N  
Date: 3/14/2011

Range: 33E

Corner Designation: 3N33A03 (Amended 3/30/2012)

Quarter corner common to Sections 6, T3NR33E; 31, T4NR33E.

_____	Condition Report Only
_____X	Not Found
_____X	Remonumented
_____	Unrecorded
_____X	Surveyed In
_____X	Referenced Out


**Previous Renewals / Surveys, etc.**

Originally surveyed by Thompson in 1864. He set a post in a mound of earth with charred stake, pits, and trench.


**Monuments and Accessories Found: (Condition and Source):**

None.

Diagram

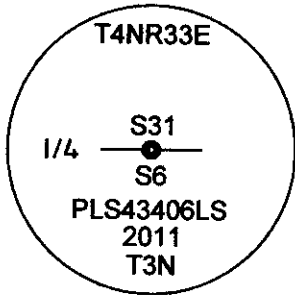

Sketch

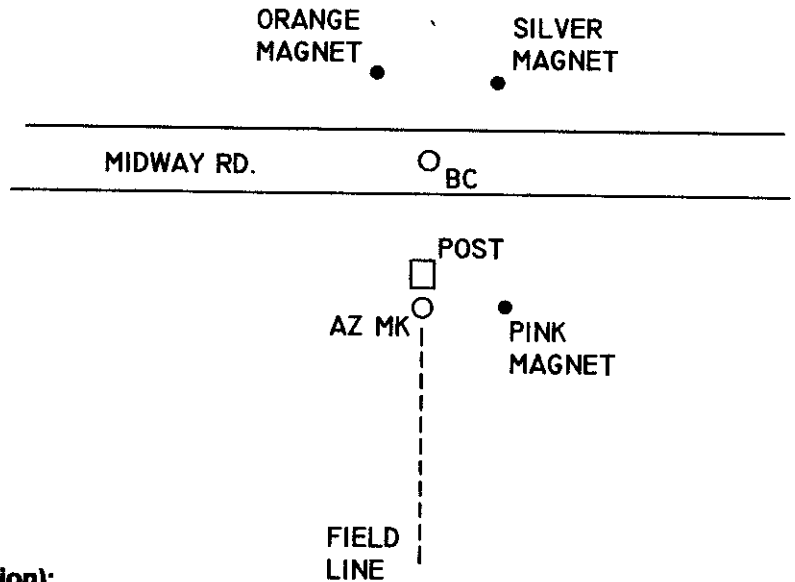

NAD 83/91  
OREGON STATE PLANE NORTH  
INTERNATIONAL FEET

N773923.50  
E8652188.30

**Monument(s) Set (Procedures and Description):**

A 1 1/8" x 30" galvanized iron pipe with a 2 1/2" brass cap, stamped as shown above, 1.5' below the surface. The location of the corner was reestablished by holding a railroad tie post at the end of a field line for Easting, and by holding the East-West line between found monuments for Northing. These are the best evidence of the original corner location.

**References Set:**

- "Deep One" magnets by Berntsen.
- An orange magnet lies N 30° 40' W, 21.56', 1.7' deep.
- A silver magnet lies N 41° 20' E, 22.71', 1.6' deep.
- A pink magnet lies S 28° E, 45.20', 1.7' deep.
- Cold Springs Azimuth Mark lies South, 34.09'.

**Location and Comments:**

The corner is located 1/2 mile East of the intersection of Midway Rd. and McCommach Rd.

**Compass Declination**

17° E

**Surveyors Seal**

REGISTERED  
PROFESSIONAL  
LAND SURVEYOR

*Robert D. English*  
OREGON  
JANUARY 11, 2005  
ROBERT DOUGLAS ENGLISH  
43406LS

RENEWAL DATE: 12/31/13

**RECEIVED BY:**

Date: 7/10/2012  
Rec'd By: S. Oles  
No. 12-094-C

**Firm / Agency**

Survey One, LLC.  
P.O. Box 382  
Pendleton, OR 97801  
(541) 276-2055