

**OREGON CORNER RESTORATION FORM**

Section 5,32 Township 3N,4N  
County Umatilla Date: 03/14/11

Range 33E

Corner Designation: 3N33A7

1/4 corner common to section 5, T3N, R33E  
and section 32, T4N, R33E, W.M.

- Condition Report Only
- Not Found
- Remonumented
- Unrecorded
- Surveyed In
- Referenced Out


**Previous Renewals / Surveys, etc.**

Originally Surveyed by Thompson in 1864. He set a post in a mound of earth.


**Monuments and Accessories Found: (Condition and Source)**

None.

Diagram

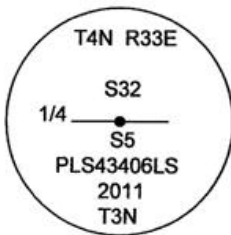

Sketch

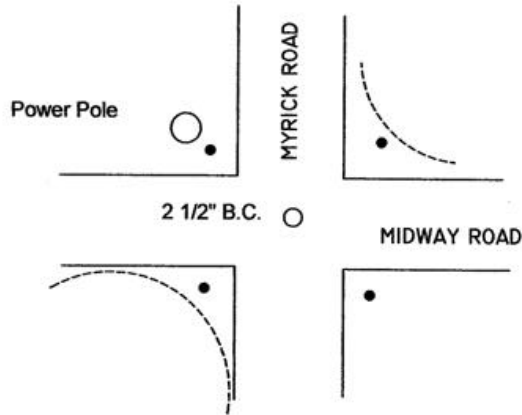

NAD 83/91  
OREGON STATE PLANE NORTH  
INTERNATIONAL FEET

N774016.29  
E8657472.16

**Monument (s) Set (Procedures and Description)**

A 1 1/8" X 30" galvanized iron pipe with a 2 1/2" brass cap, 18" below surface of road, stamped as shown above. Held centerline intersection of roads as best evidence of original corner position with reference to Umatilla County Road notes.

**References Set:** "Deep One" magnets by Berntsen.

- A Silver magnet, 20" deep, lies N 42°10' E, 42.72'.
- A 5/8" x 30" iron rebar w/rpc #43406, lies S 48°50' E, 35.89'.
- A Blue magnet, 20" deep, lies S 36°20' W, 38.65'.
- A 5/8" x 30" iron rebar w/rpc #43406, lies N 48°10' W, 37.47'.

**Location and Comments**

The corner is in the intersection of  
Midway Road and Myrick Road.

**Compass Declination**

17° E

**Surveyors Seal**

REGISTERED  
PROFESSIONAL  
LAND SURVEYOR

*Robert D. English*  
OREGON  
JANUARY 11, 2005  
ROBERT DOUGLAS ENGLISH  
43406LS

**RECEIVED BY:**

Date: \_\_\_\_\_  
Rec'd By: \_\_\_\_\_  
No. \_\_\_\_\_

**Firm / Agency**

Survey One, LLC.  
P.O. Box 382  
Pendleton, OR 97801  
(541) 276-2055

RENEWAL DATE: 12/31/09