

OREGON CORNER RESTORATION FORM

Section 2,3 Township 3N
County Umatilla Date: 03/25/11

Range 33E

Corner Designation: 3N33C17

Corner common to sections 2,3 T3NR33E.

- Condition Report Only
- Not Found
- Remonumented
- Unrecorded
- Surveyed In
- Referenced Out


Previous Renewals / Surveys, etc.

Originally Surveyed by Chaplin in 1864. He set a post in a mound of earth.

Monuments and Accessories Found: (Condition and Source)

None.


Diagram

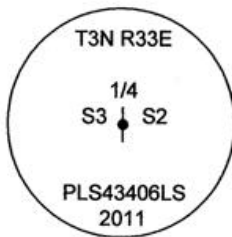

NAD 83/91
OREGON STATE PLANE NORTH
INTERNATIONAL FEET

N771605.00
E8670810.26

Sketch

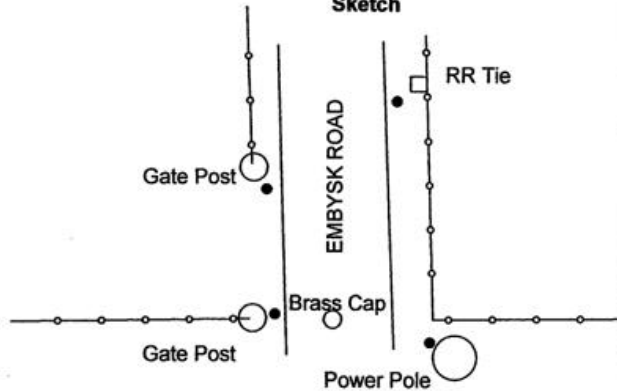

Monument (s) Set (Procedures and Description)

A 1 1/4" x 30" galvanized iron pipe with a 2 1/2" brass capped monument, 10" below the surface, stamped as shown above. There is an ancient existing East - West fence that I held for Northing, and placed the monument on line between the two found corners North and South.

References Set:

- A 5/8" x 30" iron rebar w/rpc #43406, lies N 19° W, 34.25', at a Gate Post.
- A 5/8" x 30" iron rebar w/rpc #43406, lies N 19°15' E, 68.70', at a RR Tie fence post.
- A 5/8" x 30" iron rebar w/rpc #43406, lies S 88° E, 24.74', at a Power pole.
- A 5/8" x 30" iron rebar w/rpc #43406, lies S 86° W, 9.86', at a gate post.

Location and Comments

The corner is located 1/2 mile South of the intersection of Embysk Road and Midway Road.

Compass Declination

17° E

Surveyors Seal

REGISTERED
PROFESSIONAL
LAND SURVEYOR

Robert D. English
OREGON
JANUARY 11, 2005
ROBERT DOUGLAS ENGLISH
43406LS

RECEIVED BY:

Date: _____
Rec'd By: _____
No. _____

Firm / Agency

Survey One, LLC.
P.O. Box 382
Pendleton, OR 97801
(541) 276-2055

RENEWAL DATE: 12/31/11