

OREGON CORNER RESTORATION FORM

Section: 1, 2 Township: 3N Range: 33E
County: Umatilla Date: 10/4/2011

Corner Designation: 3N33C21

Quarter corner common to Sections 1, 2, T3NR33E.



<u> X </u>	Condition Report Only
<u> </u>	Not Found
<u> </u>	Remonumented
<u> </u>	Unrecorded
<u> </u>	Surveyed In
<u> X </u>	Referenced Out

Previous Renewals / Surveys, etc.

Originally surveyed by Chaplin in 1864. He set a post in a mound of earth with charred stake and pits. In 1976 Krumbain set a brass cap in Survey M-121-C.

Monuments and Accessories Found: (Condition and Source):

A 2 1/2" brass cap, stamped as shown below, 3" below the surface.

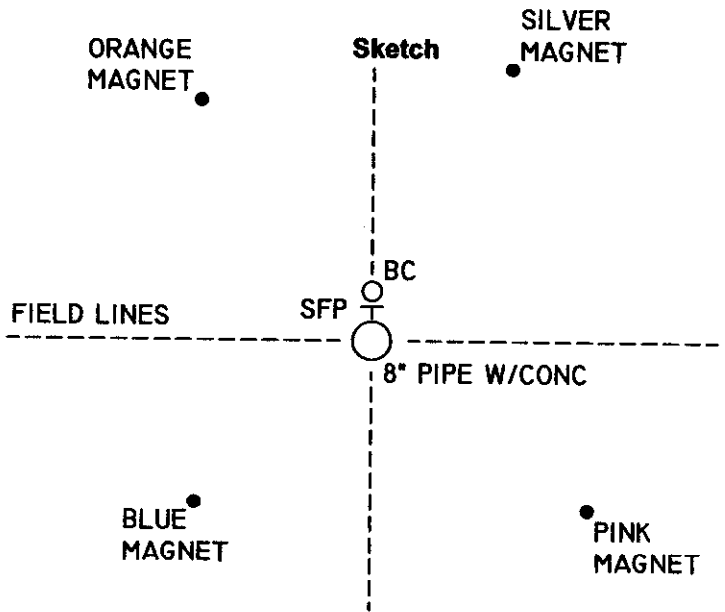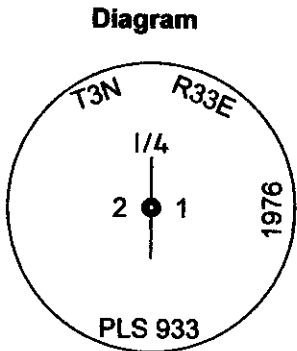

NAD 83/91
OREGON STATE PLANE NORTH
INTERNATIONAL FEET

N771762.86
E8676090.22

Monument(s) Set (Procedures and Description):

None.

References Set:

"Deep One" magnets by Berntsen.
An orange magnet lies N 40° 15' W, 27.24', 1.6' deep.
A silver magnet lies N 30° 40' E, 27.67', 1.7' deep.
A pink magnet lies S 44° 45' E, 31.40', 1.7' deep.
A blue magnet lies S 42° W, 27.70', 1.7' deep.

Location and Comments:

The corner is located 1/2 mile South and 1/2 mile East of the intersection of Midway Rd. and the Helix Hwy.

Compass Declination

17° E

Surveyors Seal

REGISTERED
PROFESSIONAL
LAND SURVEYOR

Robert D. English
OREGON
JANUARY 11, 2005
ROBERT DOUGLAS ENGLISH
43406LS

RENEWAL DATE: 12/31/13

RECEIVED BY:

Date: 7/10/2012
Rec'd By: S. Oles
No. 12-094-C

Firm / Agency

Survey One, LLC.
P.O. Box 382
Pendleton, OR 97801
(541) 276-2055