

OREGON CORNER RESTORATION FORM

Section 4 Township 3N
County Umatilla Date: 03/11/11

Range 33E

Corner Designation: 3N33E11

1/4 Corner common to sections 4 and 9, T3NR33E.

- Condition Report Only
- Not Found
- Remonumented
- Unrecorded
- Surveyed In
- Referenced Out


Previous Renewals / Surveys, etc.

Originally Surveyed by Chaplin in 1864. He set a post in a mound of earth. Krumbein set a 2 1/2" Brass cap in 1985. Survey 86-3-B.


Monuments and Accessories Found: (Condition and Source)

Found A 2 1/2" B.C. with a bent steel fence guard post within 1' South of the monumen.t

Diagram

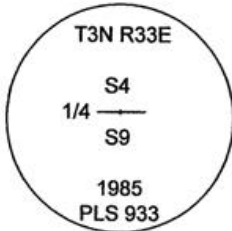

Sketch

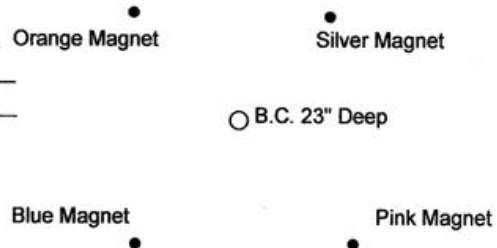

NAD 83/91
OREGON STATE PLANE NORTH
INTERNATIONAL FEET

N768806.52
E8663029.73

Monument (s) Set (Procedures and Description)

None.

References Set: "Deep One" magnets by Berntsen.

- A Silver Magnet, 17" deep, lies N 30° E, 32.36'.
- A Pink Magnet, 17" deep, lies S 39° E, 25.18'.
- A Blue Magnet, 17" deep, lies S 36°40' W, 31.81'.
- An Orange Magnet, 16" deep, lies N 44°30' W, 33.57'.

Location and Comments

The corner is 1 mile East of the intersection of Anderson Rd. and Myrick Rd. on a farm road.

Compass Declination

17° E

Surveyors Seal

REGISTERED
PROFESSIONAL
LAND SURVEYOR

Robert D. English
 OREGON
 JANUARY 11, 2005
 ROBERT DOUGLAS ENGLISH
 43406LS

RENEWAL DATE: 12/31/11

RECEIVED BY:

Date: _____
 Rec'd By: _____
 No. _____

Firm / Agency

Survey One, LLC.
 P.O. Box 382
 Pendleton, OR 97801
 (541) 276-2055