

OREGON CORNER RESTORATION FORM

Section 3 Township 3N Range 33E

County Umatilla Date 11-8-85

E-17

CORNER DESIGNATION

- Condition Report Only
- Not Found
- Renewed
- Unrecorded
- Surveyed In
- Referenced Out



Previous Renewals/Surveys, etc. None

Monument(s) & Accessories Found: (Condition and Source)

None

Monument Detail

Sketch

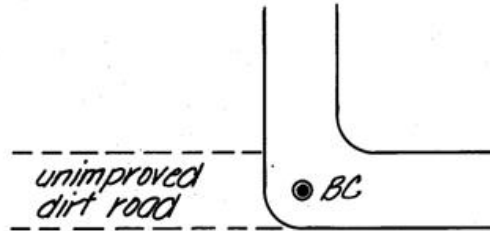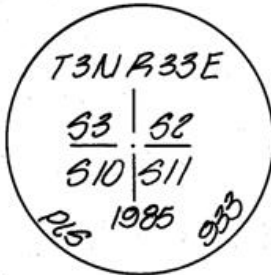

Monument Set (Procedures and Description)

2 1/2" Brass Cap on 1 1/2" galvanized pipe set at "T" intersection of  
a county road and burried 8" below surface

New Accessories

\_\_\_\_\_

Location & Comments

Surveyor's Seal

Compass Declination \_\_\_\_\_

Firm/Agency Krumbein

Engineering Ltd

Address 361 S.E. Second

Pendleton, Oregon 97801

Party Chief R. Panches

Notes \_\_\_\_\_

Witness S. Carlson

RECEIVED BY

Umatilla County Surveyor

Date 6-26-86

Rec'd By RA

No. 86-23-R

